


E-1

Description & color of materials sand, clay, red clay, shell, etc.	Thick- ness Feet	Depth Feet
clay		50
fine sand	10	60
coarse sand	43	103
tough white clay	47	150
sand	9	159
soft shale	47	206
tough clay	12	218
clay - sand sts	22	240
clay	74	314
sandy shale	71	385
rock	1	386
clay	10	396
boulders	3	399
clay	10	409
rock	1	410
shale	45	455
sand sts clay	24	479
sand	24	503
clay	12	515
sand	35	550
sandy shale	30	580

Continued -

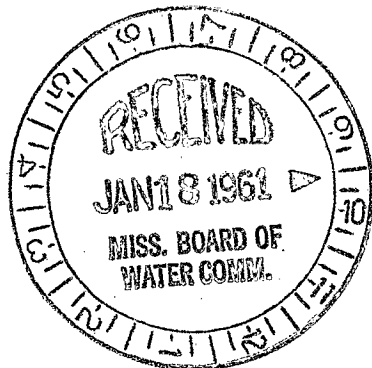

21

CODED

CODED