

PANOLA

E 28

2-77

MISSISSIPPI BOARD OF WATER COMMISSIONERS

416 North State Street

Jackson, Mississippi 39201

Robert Wilson Well Co.

WATER WELL DRILLERS LOG

CODED

Feb 1977 date well completed

Wilson's Inc firm name

Panola county well located

LANDOWNER:

D. M. Yount

H. Kew, Miss

(mailing address)

WELL LOCATION:

sec 32 T 7 N R 7 E S W 12 miles W of Sardis (distance) (direction) (nearest town)

description of formations encountered

from

to

Yellow Sand & Gravel	0	15
Heavy Gravel	15	20
White Sand	20	40
White Sand + White Clay	40	60
White Sand	60	200

WELL PURPOSE: Industrial (home, irrigation, municipal, industrial)

WELL COMPLETION DATA:

- (1) diameter (inches) 12
- (2) total depth (feet) 196
- (3) static water level (feet) 75 below top of ground.
- (4) casing Steel 156 (material) (depth) if telescope see back.
- (5) screen 40 156 (length) (depth to top) 12 BIK Louva (size) (material)
- (6) pump 60 1000 (HP) (yield gpm) 3/4 (type power)
- (7) electric log No. (yes or no) (organization running log)
- (8) how well bottom plugged Cement

CODED

RECEIVED MAR 21 1977


MISS. BD. OF WATER COMM.

DRILLERS REMARKS:

2

If well telescopes please sketch and show depths.


GROUND LEVEL

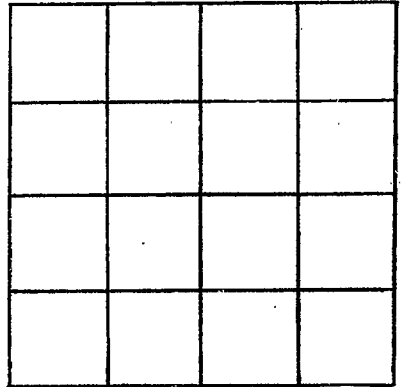

SECTION \_\_\_\_\_

Please indicate well location X.

ADDITIONAL INFORMATION

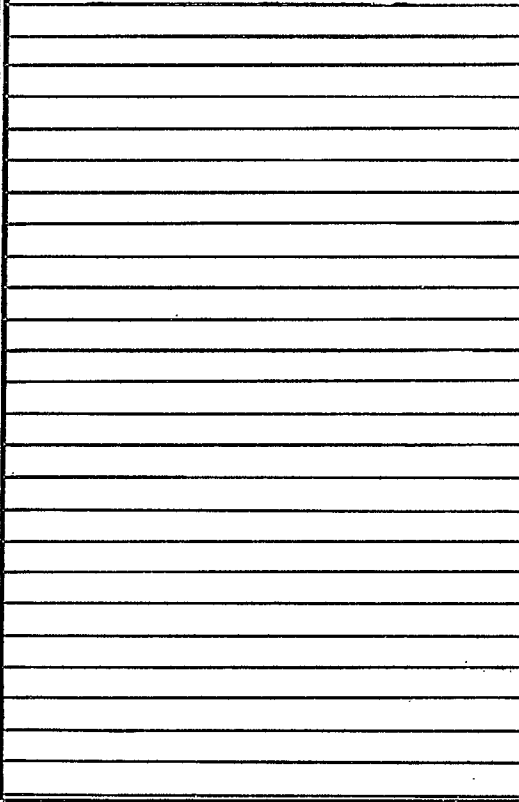

If more than one screen,  
show locations of each on sketch.