PANOLA
G24
2-28-72

MISSISSIPPI
BOARD OF WATER COMMISSIONERS
416 North State Street
Jackson, Mississippi 39201

CODED

WATER WELL DRILLERS LOG

2-28 1972 CIPE WELL CO. Panola
date well completed — firm name — county well located

LANDOWNER: Pegram
Sardis Miss.
(mailing address)

WELL LOCATION:
sec. 16 T 7 N (S) R 7 E (W)
4 miles N. W. of Sardis
(distance) (direction) (nearest town)

WELL PURPOSE: HOME
(home, irrigation, municipal, industrial)

WELL COMPLETION DATA:

(1) diameter (inches) 4"
(2) total depth (feet) 183
(3) static water level (feet) 80 below above top of ground.
(4) casing PVC (material), 175 (depth),
4" (size) if telescope see back.
(5) screen 8 (length), 175 (depth to top)
4" (size), PVC (material)
(6) pump 1½ (HP) 30 (yield gpm)
elec. (type power)
(7) electric log No (yes or no)
No (organization running log)
(8) how well bottom plugged PVC plug

DRILLERS REMARKS:

description of formations encountered	from	to
top soil	0	10
clay	10	30
coarse sand	30	50
clay & sand	50	90
sand	90	183

CODED

JUN 27 1976
MISS. BOARD OF
WATER COMMISS.

If well telescopes please sketch and show depths.

GROUND LEVEL

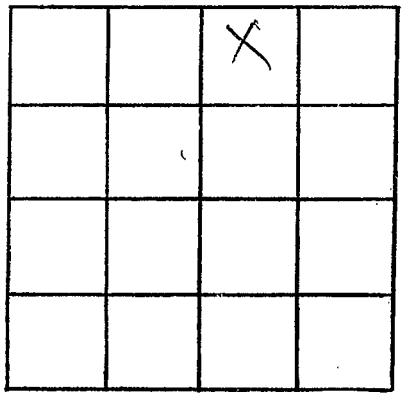

SECTION 16

Please indicate well location X.

ADDITIONAL INFORMATION

If more than one screen, show locations of each on sketch.