

PANOLA MISSISSIPPI BOARD OF WATER COMMISSIONERS

X H 8
1-26-66

James Ray Lipe
WATER WELL DRILLERS LOG

CODED

Date: 1/26, 1966, Driller: Frank Jaymes Panola
(Name)

(1) Owner of Land: John Klyce
(Name)
Sardis
(Address)

(2) Location: 1/4, 1/4, Sec. 2 T 7 R 6
5 W
9 miles east of Sardis
(distance) (direction) (Nearest Town)

(3) Topography: Hilly
(Hilly) (Flat) (Level)

(4) Purpose of Well: Dom.
(Domestic Irrigation
Municipal, Industrial, Other)

Description & Color of Materials Sand, Clay, Red Clay, Shell, etc.	Thick- ness Feet	Depth Feet
<u>Clay</u>	<u>0</u>	<u>40</u>
<u>clay + gravel</u>	<u>40</u>	<u>60</u>
<u>gravel + sand</u>	<u>20</u>	<u>145</u>
<u>pebbles</u>	<u>105</u>	<u>140</u>

Information upon completion of well:

(1) Diameter 4" inches.

(2) Total Depth 140 feet.

(3) Water Level 90 feet below top of ground.

(4) Cased to 136, Size 4"

(5) Screen: Size 4", Length 4'


(6) Were any formations sealed against pollution?
_____ yes, _____ no.

CODED

If YES depth of formation _____

Why _____

Drillers Remarks: _____

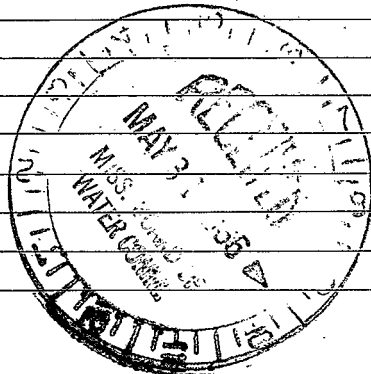

(Use Back Side)

Well No.








