MISSISSIPPI DEPARTMENT OF ENVIRONMENTAL QUALITY
Bureau of Land and Water Resources

P. O. Box 10631
Jackson, MS 39289-0631
WATER WELL DRILLERS LOG

COUNTY WELL LOCATED: Panola	
WELL NUMBER: H2026	CODED:
DATE WELL COMPLETED: 2-27-92	

PERMIT NUMBER:
NAME OF DRILLING FIRM: HICKS WELL CO.
RT. 1 BOX 157
SENATOBIA, MS 38668

NAME & MAILING ADDRESS OF LANDOWNER
Karl Dunn
3911 Walnut Grove
Memphis, Tn 38111

WELL LOCATION: SEC 14 TOWNSHIP 7 N (S) RANGE 6 E (W)

DISTANCE 10 Miles DIRECTION SE of NEAREST TOWN Como

OTHER LANDMARK

WELL PURPOSE: Home, Irrigation, Municipal, Industrial, Fish Pond, etc.

PUMP DATA

PUMP TYPE (Circle One): Submersible, Turbine, Jet, Flowing Well, Other (Describe)

POWER TYPE (Circle One): Electric, Tractor, Diesel, Gasoline, Butane, Other (Describe) H/P 1/2

Pump Capacity (GPM)	No. of Stages	Setting Depth
10	9	120 FT.

PUMP TEST

Well yielded 10 GPM with a drawdown of _____ ft. after _____ hours of pumping

WELL DATA

Well Depth	Casing Diameter (In.)	Casing Length (Ft.)
165	4"	165

Type of Casing	Hole Depth	Depth to Static Water Level
PVC	165	115

TYPE OF COMPLETION: (Circle One or More): Gravel Packed, Underreamed, Telescoped, Natural Development, Open Hole, Other (Describe)

Top of Lap Pipe or Reduction in Casing FEET

IF TELESCOPED OR MORE THAN ONE SCREEN: USE BACK PAGE

SCREEN DATA

Diameter - Inches	Length - Feet	Slot Size - Inches
4"	10	013

Screen Type	Depth to Bottom - Feet
PVC	10

LOG DATA

TYPE OF LOG RUN (Circle One): No Log Run, Electric, Gamma Ray, Density, Sonic, Neutron, Other (Describe)

Name of Organization Running Log

GEOLOGIC DATA (Office Use Only)

Surface Elev.	Geologic Unit	Unit Thickness	Depth to Top
Subs. SWL	Date	Analysis	Aquifer Test

Driller's Remarks

DESCRIPTION OF FORMATIONS ENCOUNTERED	FROM	TO
dirt	0	10
Rock	10	15
Brown Clay	15	140
sand	140	165

FORMATIONS (Continued)	FROM	TO

RECEIVED
JUL 27 1992
Dept. of Environmental Quality
Bureau of Land & Water Resources

IF MORE SPACE IS NEEDED, USE BACK

If well telescopes please
sketch and show depths.

GROUND LEVEL

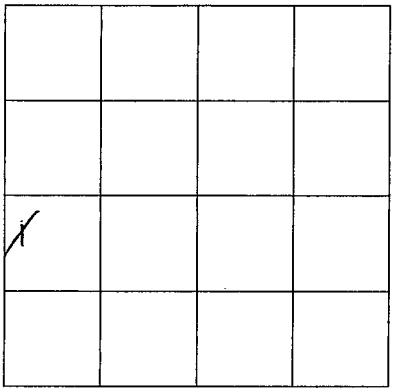

SECTION _____

Please indicate well location X.

ADDITIONAL INFORMATION

If more than one screen,
show location of each on sketch.