PANOLA
J1
1-10-72

MISSISSIPPI
BOARD OF WATER COMMISSIONERS
416 North State Street
Jackson, Mississippi 39201

CODED

WATER WELL DRILLERS LOG

1/10/ 1972 G. and H. Well Co. ~~Marshal~~ Panola
date well completed — firm name — county well located

LANDOWNER:
Robert p. Foggo
Route 5 Box 405,
Sardis, Mississippi
(mailing address)

WELL LOCATION:
sec. 19 T 27 N (S) R 5 E (W)
10 miles East of Sardis
(distance) (direction) (nearest town)

WELL PURPOSE: Home
(home, irrigation, municipal, industrial)

WELL COMPLETION DATA:
(1) diameter (inches) 4 ~~XX~~ In.
(2) total depth (feet) 210
(3) static water level (feet) 130 below above top of ground.
(4) casing Plastic (material), 210 (depth),
_____ (size) If telescope see back.
(5) screen 5 FT. (length), 205 FT. (depth to top)
4 In. (size), Gravel (material)
(6) pump 3/4 (HP) 10Gpm (yield gpm)
Electric (type power)
(7) electric log No (yes or no)
_____ (organization running log)
(8) how well bottom plugged Cap

DRILLERS REMARKS:

description of formations encountered	from	to
Red Sand	1	15
" "	25	30
" "	30	40
" "	40	50
Black Clay	50	60
" "	60	70
Black & White Clay	70	80
White Clay	80	90
" X "	90	100
" "	100	110
" "	110	120
Black & White Clay	120	130
" " "	130	140
" " "	140	150
" " "	150	160
Black Clay	160	170
" "	170	180
" "	180	190
Black Clay & Sand	190	200
" " "	200	210

CODED
JAN 13 1972
MISS. BD. OF WATER COMM.

If well telescopes please sketch and show depths.

GROUND LEVEL

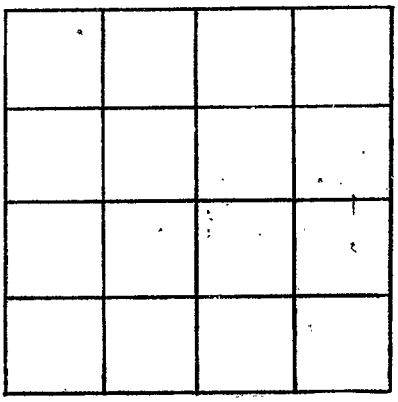

SECTION _____

Please indicate well location X.

ADDITIONAL INFORMATION

If more than one screen, show locations of each on sketch.