PANOLA
L12
5-20-71

MISSISSIPPI
BOARD OF WATER COMMISSIONERS
416 North State Street
Jackson, Mississippi 39201

CODED

WATER WELL DRILLERS LOG

May 20 1971 — Lipe Well Co — Panola
date well completed — firm name — county well located

LANDOWNER: Shedrick Prazier
Batesville Miss
(mailing address)

WELL LOCATION:
sec. 34 T 8 N (S) R 8 (E) W
6 miles NW of Batesville
(distance) (direction) (nearest town)

WELL PURPOSE: Home
(home, irrigation, municipal, industrial)

WELL COMPLETION DATA:

(1) diameter (inches) 4"
(2) total depth (feet) 106'
(3) static water level (feet) 20 (below / above) top of ground.
(4) casing PVC (material), 96' (depth), 4" (size) if telescope see back.
(5) screen 10' (length), 96' (depth to top), 4" (size), PVC (material) asbestos
(6) pump 3/4 (HP) 10 (yield gpm)
elec (type power)
(7) electric log no (yes or no)
(organization running log)
(8) how well bottom plugged PVC cap

DRILLERS REMARKS:

description of formations encountered	from	to
top soil	0	5
clay	5	70
sand	70	106

CODED

OCT 12 1971
MISS. BD. OF WATER COMM.

If well telescopes please sketch and show depths.

GROUND LEVEL

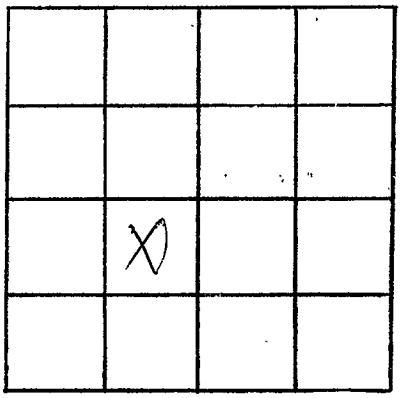

SECTION 34

Please indicate well location X.

ADDITIONAL INFORMATION

If more than one screen, show locations of each on sketch.