PANOLA
L 15
6-72

MISSISSIPPI
BOARD OF WATER COMMISSIONERS
416 North State Street
Jackson, Mississippi 39201

CODED

WATER WELL DRILLERS LOG

1972 date well completed — LOPE WELL CO. firm name — Panola county well located

LANDOWNER: EMMA BAKER
Batesville Miss.
(mailing address)

WELL LOCATION:
sec. 33 T 8 N (S) R 8 E (W)
6 miles N W of Batesville
(distance) (direction) (nearest town)

WELL PURPOSE: home
(home, irrigation, municipal, industrial)

WELL COMPLETION DATA:

(1) diameter (inches) 4"
(2) total depth (feet) 150'
(3) static water level (feet) 80 below above top of ground.
(4) casing PVC (material), 142 (depth), 4" (size) if telescope see back.
(5) screen 8' (length); 142 (depth to top) 4" (size), PVC (material)
(6) pump 3/4 (HP) 10 (yield gpm) Elec. (type power)
(7) electric log no (yes or no) no (organization running log)
(8) how well bottom plugged PVC PLUG

DRILLERS REMARKS:

description of formations encountered	from	to
top soil	0	10
sand	10	60
gravel	60	80
clay	80	90
sand	90	150

CODED

JUN 27 1972
MISS. BD. OF
WATER COMM.

If well telescopes please sketch and show depths.

GROUND LEVEL

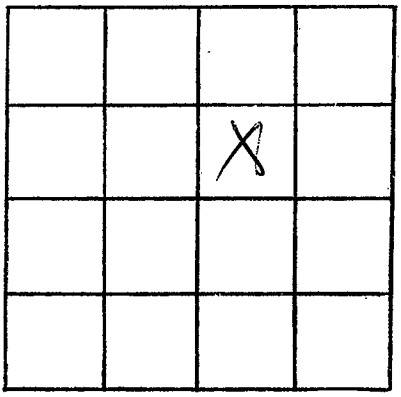

SECTION 33

Please indicate well location X.

ADDITIONAL INFORMATION

If more than one screen, show locations of each on sketch.