PANOLA
M14
5-24-71

MISSISSIPPI
BOARD OF WATER COMMISSIONERS
416 North State Street
Jackson, Mississippi 39201

WATER WELL DRILLERS LOG

CODED

May 29 1971 Lipe Well Co.
date well completed — firm name — county well located

LANDOWNER: Guy Hyde
Sardis, Miss
(mailing address)

WELL LOCATION:
sec. 8 T 8 N (S) R 7 E (W)
5 miles SW of Sardis
(distance) (direction) (nearest town)

WELL PURPOSE: home
(home, irrigation, municipal, industrial)

WELL COMPLETION DATA:

(1) diameter (inches) 4"
(2) total depth (feet) 200'
(3) static water level (feet) 110 below above top of ground.
(4) casing PVC (material), 190' (depth), 4" (size) if telescope see back.
(5) screen 10' (length), 190' (depth to top), 4" (size), PVC & silica (material)
(6) pump 1 (HP) 12 (yield gpm)
elec (type power)
(7) electric log no (yes or no)
(organization running log)
(8) how well bottom plugged PVC cap

DRILLERS REMARKS:

description of formations encountered	from	to
top soil	0	10
red sand	10	20
sand & gravel	20	50
sand & clay	50	80
clay	80	120
sand	120	200

CODED

OCT 12 1971
MISS. BD. OF WATER COMM.

If well telescopes please sketch and show depths.

GROUND LEVEL

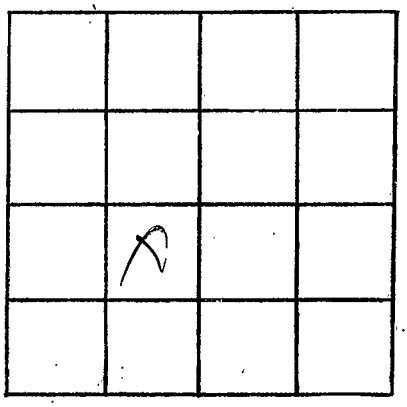

SECTION 8

Please indicate well location X.

ADDITIONAL INFORMATION

If more than one screen, show locations of each on sketch.