PANOLA
Ø 2000
7-22-77

15F

MISSISSIPPI
BOARD OF WATER COMMISSIONERS
416 North State Street
Jackson, Mississippi 39201

WATER WELL DRILLERS LOG

July 22 1977 Lipe Well Co. Panola
date well completed — firm name — county well located

LANDOWNER: Mr. Morris Montgomery
Batesville MS.
(mailing address)

WELL LOCATION:
sec. 21 T 8 N (S) R 6 E (W)
10 miles east of Batesville
(distance) (direction) (nearest town)

WELL PURPOSE:
(home, irrigation, municipal, industrial)

WELL COMPLETION DATA:

(1) diameter (inches) 4
(2) total depth (feet) 120
(3) static water level (feet) 60 below above top of ground.
(4) casing PVC (material), 110 (depth),
4 (size) if telescope see back.
(5) screen 10 (length), 110 (depth to top)
4 (size), PVC (material)
(6) pump 3/4 (HP) 10 (yield gpm)
elec. (type power)
(7) electric log no (yes or no)
no (organization running log)
(8) how well bottom plugged PVC Cap

DRILLERS REMARKS:

description of formations encountered	from	to
Top Soil	0	20
Clay and sand	20	40
" " "	40	60
black clay	60	80
sand and clay	80	100
Sand	100	120

RECEIVED
AUG - 1 1977
MISS. BD. OF WATER COMM

If well telescopes please sketch and show depths.

GROUND LEVEL

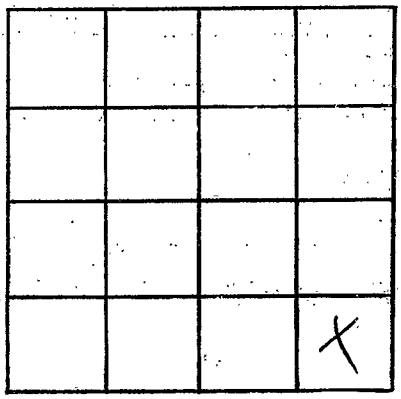

SECTION 21

Please indicate well location X.

ADDITIONAL INFORMATION

If more than one screen, show locations of each on sketch.