PANOLA
Ø 2003
7/28/77

15F

MISSISSIPPI
BOARD OF WATER COMMISSIONERS
416 North State Street
Jackson, Mississippi 39201

WATER WELL DRILLERS LOG

July 28 1977 — date well completed
Lipe Well Co. — firm name
Panola — county well located

LANDOWNER:
T. T. Carpenter
Batesville Ms.
(mailing address)

WELL LOCATION:
sec. 21 T. 8 N (S) R. 5 E (W)
10 miles (distance) East (direction) of Batesville (nearest town)

WELL PURPOSE:
(home) irrigation, municipal, industrial

WELL COMPLETION DATA:

(1) diameter (inches) 4
(2) total depth (feet) 200
(3) static water level (feet) 140 below above top of ground.
(4) casing PVC (material), 190 (depth),
4 (size) if telescope see back.
(5) screen 10 (length), 190 (depth to top)
4 (size), PVC (material)
(6) pump 3/4 (HP) 10 (yield gpm)
elec. (type power)
(7) electric log no (yes or no)
no (organization running log)
(8) how well bottom plugged PVC cap

DRILLERS REMARKS:

description of formations encountered	from	to
Top soil	0	20
red sand	20	70
sand and clay	70	90
clay	90	120
clay and sand	120	160
clay	160	180
sand	180	200

RECEIVED
AUG - 1 1977
MISS. BD. OF WATER COMM.

If well telescopes please sketch and show depths.

GROUND LEVEL

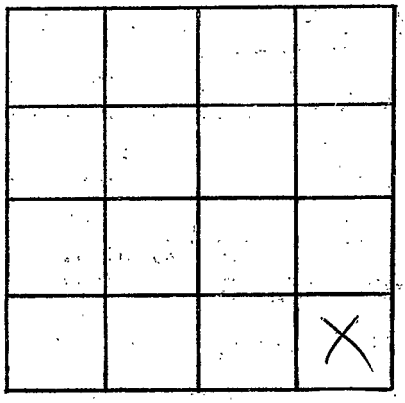

SECTION 21

Please indicate well location X.

ADDITIONAL INFORMATION

If more than one screen, show locations of each on sketch.