


R

10-1-63

WATER WELL DRILLERS LOG

Date: 10 / 1, 1963, Driller: J. B. [Signature] County: Panola
 (Name)

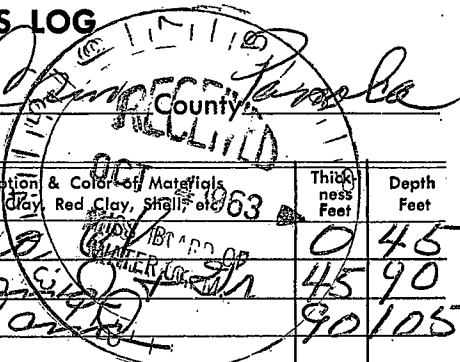

(1) Owner of Land:	Description & Color of Materials Sand, Clay, Red Clay, Shell, etc.	Thick- ness Feet	Depth Feet
<u>Henry Echoles</u> (Name) <u>Batesville miss</u> (Address)	<u>Br. [Signature]</u> <u>[Signature]</u> <u>[Signature]</u>	<u>0</u> <u>45</u> <u>90</u> <u>105</u>	<u>45</u> <u>90</u> <u>105</u>
(2) Location: <u>1/4</u> , <u>1/4</u> , Sec. <u> </u> T <u> </u> R <u> </u> <u>1</u> miles <u>E</u> , of <u>Batesville</u> (distance) (direction) (Nearest Town)			
(3) Topography: <input checked="" type="checkbox"/> (Hilly) <input type="checkbox"/> (Flat) <input type="checkbox"/> (Level)			
(4) Purpose of Well: <u>Home</u> (Domestic Irrigation, Municipal, Industrial, Other)			

Information upon completion of well:

(1) Diameter 4 inches.

(2) Total Depth 105 feet.

(3) Water Level 85 feet below top of ground.

(4) Cased to 105, Size 4"

(5) Screen: Size 6", Length 4 FT
Plastic well

(6) Were any formations sealed against pollution?
 _____ yes, _____ no.

If YES depth of formation _____

Why _____

Drillers Remarks: _____

(Use Back Side)

Well No.





