Panola
S 59
3-31-74

MISSISSIPPI
BOARD OF WATER COMMISSIONERS
416 North State Street
Jackson, Mississippi 39201

WATER WELL DRILLERS LOG

CODED

3-31-1974 — date well completed
W. R. Mason — firm name
Panola — county well located

LANDOWNER: Harry Smith
Memphis Tennessee
(mailing address)

WELL LOCATION:
sec. 34 T. 9 N (S) R. 6 E (W)
2 1/2 miles NE of Eureka Springs
(distance) (direction) (nearest town)

WELL PURPOSE: Home
(home, irrigation, municipal, industrial)

WELL COMPLETION DATA:

(1) diameter (inches) 4"
(2) total depth (feet) 150'
(3) static water level (feet) 105 below ~~above~~ top of ground.
(4) casing Plastic (material), 130' (depth), 4" (size) if telescope see back.
(5) screen 20' (length), 130' (depth to top), 4" (size), Plastic (material)
(6) pump 1 (HP) 30 (yield gpm)
electric (type power)
(7) electric log No (yes or no)
(organization running log)
(8) how well bottom plugged Cap

DRILLERS REMARKS:

description of formations encountered	from	to
Clay Dirt	0	10
Red Sand	10	30
White Sand	30	150

CODED

RECEIVED
DEC 27 1974
MISS. BD. OF WATER COMM

If well telescopes please sketch and show depths.

GROUND LEVEL

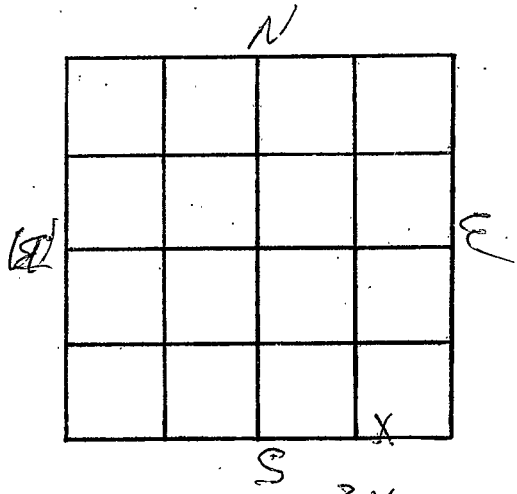

SECTION 3 20

Please indicate well location X.

ADDITIONAL INFORMATION

If more than one screen, show locations of each on sketch.