PANOLA
S60
3-29-74

MISSISSIPPI
BOARD OF WATER COMMISSIONERS
416 North State Street
Jackson, Mississippi 39201

WATER WELL DRILLERS LOG

3-29-1974 — W.A. Mason — Panola
date well completed — firm name — county well located

LANDOWNER: J. D. Henderson
RFD. Batesville Miss.
(mailing address)

WELL LOCATION:
sec. 34 T 9 N (S) R 6 E (W)
2 1/2 miles (distance) NE (direction) of Enterprise Springs (nearest town)

WELL PURPOSE: Home
(home, irrigation, municipal, industrial)

WELL COMPLETION DATA:

(1) diameter (inches) 4"
(2) total depth (feet) 147'
(3) static water level (feet) 95' below above top of ground.
(4) casing Plastic (material), 137' (depth), 4" (size) if telescope see back.
(5) screen 10' (length), 137' (depth to top), 4" (size), Plastic (material)
(6) pump 3/4 (HP) 7 (yield gpm) electric (type power)
(7) electric log No (yes or no)
(organization running log)
(8) how well bottom plugged Cap

DRILLERS REMARKS:

description of formations encountered	from	to
clay soil	0	20
red sand	20	35
gravel	35	80
white sand	80	147

RECEIVED
DEC 27 1974
MISS. BD. OF WATER COMM

If well telescopes please sketch and show depths.

GROUND LEVEL

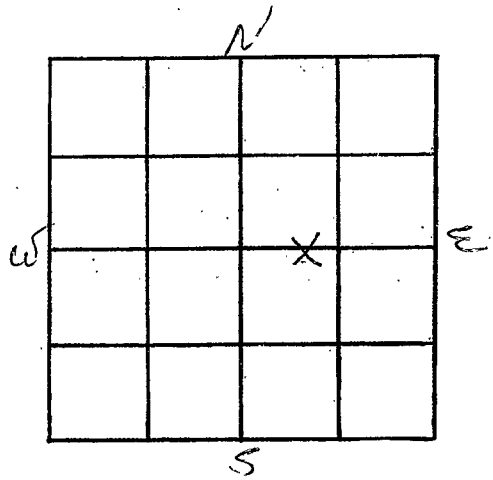

SECTION 34

Please indicate well location X.

ADDITIONAL INFORMATION

If more than one screen, show locations of each on sketch.