Panola
S 61
1-1-75

MISSISSIPPI
BOARD OF WATER COMMISSIONERS
416 North State Street
Jackson, Mississippi 39201 CODED

WATER WELL DRILLERS LOG

Jan. 1 - 1975 19 W. Q. Mason Water Well Contr. Panola
date well completed — firm name — county well located

LANDOWNER: Son. Charles R. Nix
Batesville Mississippi
(mailing address)

WELL LOCATION:
sec. 35 T 9 N (S) R 6 E (W) 15F
3 1/2 miles NE of Eureka
(distance) (direction) (nearest town)

WELL PURPOSE: Home
(home, irrigation, municipal, industrial)

WELL COMPLETION DATA:

(1) diameter (inches) 4"
(2) total depth (feet) 190'
(3) static water level (feet) 115' below ~~above~~ top of ground.
(4) casing Plastic (material), 95' (depth),
4" (size) if telescope see back.
(5) screen 20' (length), 95' (depth to top)
4" (size), Plastic (material)
(6) pump 1/2 (HP) 5 (yield gpm)
electric (type power)
(7) electric log No (yes or no)
(organization running log)
(8) how well bottom plugged Cap on screen

DRILLERS REMARKS:

description of formations encountered	from	to
clay top soil	0	20
red clay	20	60
white clay	60	90
white sand	90	120
blue clay	120	165
gray sand	165	190
black clay	at	190

CODED

RECEIVED
DEC 01 1975
MISS. BD. OF WATER COMM.

If well telescopes please sketch and show depths.

GROUND LEVEL

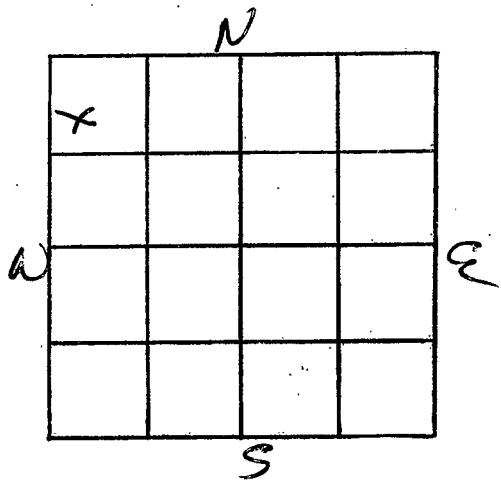

SECTION 35

Please indicate well location X.

ADDITIONAL INFORMATION

If more than one screen, show locations of each on sketch.