

Parola  
T 8  
3-18-65

MISSISSIPPI BOARD OF WATER COMMISSIONERS

James A. Lipe  
WATER WELL DRILLERS LOG

CODED

Date: 3, 18, 1965, Driller: Frank Taylor County Parola  
(Name)

(1) Owner of Land: Dees, Selma  
(Name)  
Batesville, Miss  
(Address)  
(2) Location: 1/4, 1/4, Sec 31 T 8 R 11 W  
12 miles S. east of Batesville  
(distance) (direction) (Nearest Town)  
(3) Topography: Hilly  
(Hilly) (Flat) (Level)  
(4) Purpose of Well: Domestic  
(Domestic Irrigation  
Municipal, Industrial, Other)


Description & Color of Materials Sand, Clay, Red Clay, Shell, etc.	Thick- ness Feet	Depth Feet
Red Sand	0	83
White "	83	155
Red "	155	158
Rock at	158	

Information upon completion of well:

(1) Diameter 4 inches.  
(2) Total Depth 158' feet.  
(3) Water Level 100' feet below top of ground.  
(4) Cased to 152, Size 4"  
(5) Screen: Size 4", Length 6'  
(6) Were any formations sealed against pollution?  
\_\_\_\_\_ yes, \_\_\_\_\_ no.

If YES depth of formation \_\_\_\_\_  
Why \_\_\_\_\_

Drillers Remarks:  
Cut into rock 8"  
didn't cut through  
pointed on top of rock

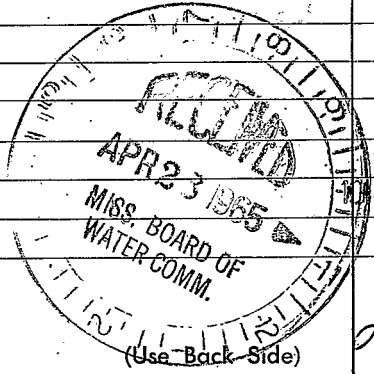

Well No. 24










