

5-10-64

WATER WELL DRILLERS LOG

Date: 5-10, 1964, Driller: J B Carr County Pandla

(Name)

(1) Owner of Land: Shelton Hunt
Courtland
 (Name)
 (Address)

Description & Color of Materials
 Sand, Clay, Red Clay, Shell, etc.

Thick-
ness
Feet

Depth
Feet

Sand + sh
Blue cl
Sand
 0 70
 70 180
 180 200

(2) Location: 1 miles N of Pape
 (distance) (direction) (Nearest Town)

(3) Topography: ✓
 (Hilly) (Flat) (Level)

(4) Purpose of Well: Home
 (Domestic Irrigation
 Municipal, Industrial, Other)


Information upon completion of well:

- (1) Diameter 2 inches.
- (2) Total Depth 200 feet.
- (3) Water Level 45 feet below top of ground.
- (4) Cased to 200, Size 2"
- (5) Screen: Size 1/4, Length 5.
- (6) Were any formations sealed against pollution?
 _____ yes, _____ no.

If YES depth of formation _____

Why _____

Drillers Remarks: _____

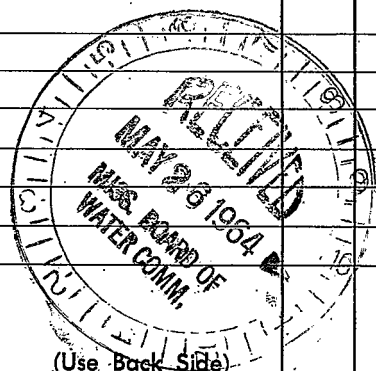

Well No.









