PANOLA
W32
6-5-73
Elev #99

MISSISSIPPI
BOARD OF WATER COMMISSIONERS
416 North State Street
Jackson, Mississippi 39201

CODED

WATER WELL DRILLERS LOG

June 5 1973 — date well completed
LIPE WELL & SUPPLY CO. — firm name
PANOLA — county well located

LANDOWNER:
U.S. C.E.
VICKSBURG DISTRICT
(mailing address)

WELL LOCATION:
sec. 34 T 10 N (S) R 6 E (W)
7 miles (distance) W (direction) of Pope (nearest town)

WELL PURPOSE: Recreation facilities
(home, irrigation, municipal, industrial)

WELL COMPLETION DATA:

(1) diameter (inches) 6"
(2) total depth (feet) 615'
(3) static water level (feet) 88 below (above) top of ground.
(4) casing Steel (material), 540' (depth), 6" (size) if telescope see back.
(5) screen 30' (length), 564' (depth to top), 4" (size), S.S. (material)
(6) pump 3 (HP) 40 (yield gpm)
elec (type power)
(7) electric log yes (yes or no)
USGS (organization running log)
(8) how well bottom plugged steel plug

DRILLERS REMARKS:

description of formations encountered	from	to
top soil sand	0	22
red clay, sand	22	45
red, white sand	45	68
Gumbo	68	91
Gumbo	91	117
Sandy shale	117	137
Shale	137	157
Sandy Gumbo	157	237
Gumbo	237	317
Lignite	317	327
White Coarse sand	327	342
Shale	342	357
Soft Gumbo	357	417
Hard Shale	417	497
Mixed Shale	497	557
Sanded	557	588
Sandy Gumbo	588	604
Sand	604	615
Mixed Shale	615	677
Shale	677	717

RECEIVED
DEC 9 1974
MISS. BD. OF WATER COMM.

If well telescopes please sketch and show depths.

GROUND LEVEL

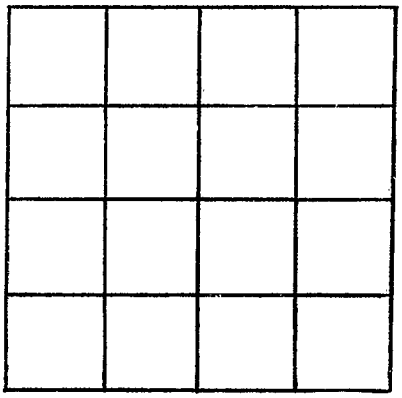

SECTION _____

Please indicate well location X.

ADDITIONAL INFORMATION

If more than one screen, show locations of each on sketch.