MISSISSIPPI DEPARTMENT OF ENVIRONMENTAL QUALITY
Office of Land and Water Resources

P. O. Box 10631
Jackson, MS 39289-0631
WATER WELL DRILLERS LOG

COUNTY WELL LOCATED	Pearl River
WELL NUMBER	A-2040
CODED	
PERMIT NUMBER	0-586
NAME OF DRILLING FIRM	James Wells Water Well Service
DATE WELL COMPLETED	4-6-2000

NAME & MAILING ADDRESS OF LANDOWNER
Laura Entrekin
2720 Fords Creek Rd.
Poplarville, MS. 39470

WELL LOCATION SEC	TOWNSHIP	RANGE
29	1 N (S)	17 E (W)

DISTANCE	DIRECTION	NEAREST TOWN
10 Miles	South of	Poplarville

OTHER LANDMARK: Ford Creek

WELL PURPOSE: (Home), Irrigation, Municipal, Industrial, Fish Pond, etc.

PUMP DATA

PUMP TYPE (Circle One): (Submersible), Turbine, Jet, Flowing Well, Other (Describe) _____

POWER TYPE (Circle One): (Electric), Tractor, Diesel, Gasoline, Butane, Other (Describe) _____ H/P 1

Pump Capacity (GPM)	No of Stages	Setting Depth
		FT.

PUMP TEST

Well yielded 15 GPM with a drawdown of _____ ft. after _____ hours of pumping

WELL DATA

Well Depth	Casing Diameter (In.)	Casing Length (Ft.)
170	4	150

Type of Casing	Hole Depth	Depth to Static Water Level
PVC	170	80

TYPE OF COMPLETION: (Circle One or More): (Gravel Packed), Underreamed, Telescoped, Natural Development, Open Hole, Other (Describe) _____

WELL GROUTED TO A DEPTH OF 15 FEET
Type Grout (circle one): (Cement), Bentonite, or Mix

LOG DATA

TYPE OF LOG RUN (Circle One): No Log Run, Electric, Gamma Ray, Density, Sonic, Neutron, Other (Describe) _____

Name of Organization Running Log

GEOLOGIC DATA (Office Use Only)

Surface Elev	Geologic Unit	Unit Thickness	Depth to Top
Subs. SWL	Date	Analysis	Aquifer Test

Driller's Remarks

SCREEN DATA

Diameter - Inches	Length - Feet	Slot Size - Inches
4	20	80

Screen Type	Depth to Bottom - Feet
PVC Slot	150-170

Top of Lap Pipe or Reduction in Casing
FEET

IF TELESCOPED OR MORE THAN ONE SCREEN, USE BACK PAGE

DESCRIPTION OF FORMATIONS ENCOUNTERED	FROM	TO
Top Soil	0	2
Clay	2	15
Sand	15	30
Blue Clay	30	120
Sand	120	170

FORMATIONS (Continued)

	FROM	TO

IF MORE SPACE IS NEEDED, USE BACK

JUL 20 2000
Dept. of Environmental Quality
Office of Land & Water Resources

If well telescopes please
sketch and show depths.

GROUND LEVEL

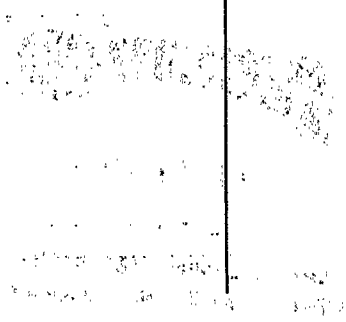

If more than one screen,
show location of each on sketch.

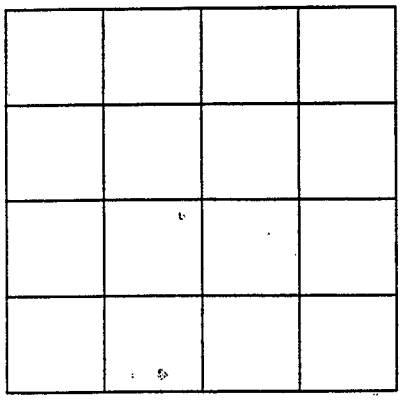

SECTION _____

Please indicate well location X.

ADDITIONAL INFORMATION