COUNTY WELL LOCATED: Pearl River

WELL NUMBER: C-2038 | CODED:

DATE WELL COMPLETED: 4-9-01

PERMIT NUMBER:

NAME OF DRILLING FIRM: Boone's Water Well

MISSISSIPPI DEPARTMENT OF ENVIRONMENTAL QUALITY
Office of Land and Water Resources

P. O. Box 10631
Jackson, MS 39289-0631

WATER WELL DRILLERS LOG

NAME & MAILING ADDRESS OF LANDOWNER
Mike Pisani
46 Magnolia Rd
Lumberton, MS 39455

WELL LOCATION: SEC 24 TOWNSHIP 1 N (S) RANGE 15 E (W)

DISTANCE 5 Miles DIRECTION S of NEAREST TOWN Lumberton

OTHER LANDMARK

WELL PURPOSE: (Home), Irrigation, Municipal, Industrial, Fish Pond, etc.

PUMP DATA

PUMP TYPE (Circle One): Submersible, Turbine, (Jet), Flowing Well, Other (Describe)

POWER TYPE (Circle One): (Electric), Tractor, Diesel, Gasoline, Butane, Other (Describe) H/P 2

Pump Capacity (GPM)	No. of Stages	Setting Depth
5		FT.

PUMP TEST

Well yielded _____ GPM with a drawdown of _____ ft. after _____ hours of pumping

WELL DATA

Well Depth	Casing Diameter (In.)	Casing Length (Ft.)
170	2	160

Type of Casing	Hole Depth	Depth to Static Water Level
SCH40	170	125

TYPE OF COMPLETION: (Circle One or More): (Gravel Packed), Underreamed, Telescoped, (Natural Development), Open Hole, Other (Describe)

WELL GROUTED TO A DEPTH OF 10 FEET
Type Grout (circle one): (Cement), Bentonite, or Mix

LOG DATA

TYPE OF LOG RUN (Circle One): No Log Run, Electric, Gamma Ray, Density, Sonic, Neutron, Other (Describe)

Name of Organization Running Log

GEOLOGIC DATA (Office Use Only)

Surface Elev.	Geologic Unit	Unit Thickness	Depth to Top
Subs. SWL	Date	Analysis	Aquifer Test

Driller's Remarks

Top of Lap Pipe or Reduction in Casing FEET

IF TELESCOPED OR MORE THAN ONE SCREEN: USE BACK PAGE

SCREEN DATA

Diameter - Inches	Length - Feet	Slot Size - Inches
2	10	#8

Screen Type	Depth to Bottom - Feet
SCH40	

DESCRIPTION OF FORMATIONS ENCOUNTERED	FROM	TO
Sand	0	40
Clay	40	130
Sand	130	170

FORMATIONS (Continued)	FROM	TO

REC'D AUG 24 2001

IF MORE SPACE IS NEEDED, USE BACK

If well telescopes please
sketch and show depths.

GROUND LEVEL

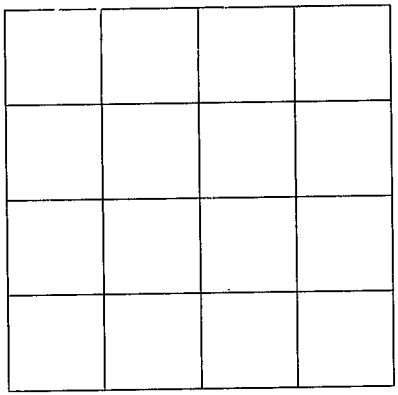

SECTION _____

Please indicate well location X.

ADDITIONAL INFORMATION

If more than one screen,
show location of each on sketch.