Pearl River
D 2007
10-14-81

MISSISSIPPI DEPARTMENT OF NATURAL RESOURCES

Bureau of Land and Water Resources
Southport Mall
P.O. Box 10631
Jackson, Mississippi 39209

WATER WELL DRILLERS LOG

Oct. 14, 1981 — date well completed
Cochran Brothers Drilling Service — firm name
Pearl River — county well located

LANDOWNER: John Sawyer
Rt 3 Lumberton
(mailing address)

WELL LOCATION:
sec. 5 T 1 N (S) R 14 E (W)
1/2 (distance) miles E (direction) of Lumberton (nearest town)

WELL PURPOSE: (home, irrigation, municipal, industrial)

WELL COMPLETION DATA:

(1) diameter (inches) 4"
(2) total depth (feet) 105'
(3) static water level (feet) 55 below / above top of ground.
(4) casing PVC (material), 95' (depth), — (size) if telescope see back.
(5) screen 10' (length), 95' (depth to top), 2" (size), PVC (material)
(6) pump 1 Sub (HP) 25 (yield gpm) Elec (type power)
(7) electric log no (yes or no)
(organization running log)
(8) how well bottom plugged VA Vil

DRILLERS REMARKS:

description of formations encountered	from	to
Top Soil	0	2
red clay	2	5
red sand	5	25
gray clay	25	46
sand	46	71
Blue clay	71	80
sand	80	105

DEPT. OF NATURAL RESOURCES
BUREAU OF LAND & WATER RESOURCES
DEC - 3 1981
RECEIVED

If well telescopes please sketch and show depths.

GROUND LEVEL

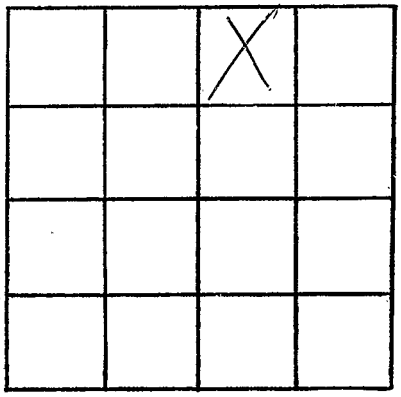

SECTION 5

Please indicate well location X.

ADDITIONAL INFORMATION

If more than one screen, show locations of each on sketch.