P. River
E 2056

MISSISSIPPI DEPARTMENT OF NATURAL RESOURCES
Bureau of Land and Water Resources
Southport Mall
P.O. Box 10631
Jackson, Mississippi 39209

WATER WELL DRILLERS LOG

3/23 (date well completed) 19 91 Bert Denton (firm name) Pearl River (county well located)

LANDOWNER: Marvice W. Leaf
Route 2 Box 244 A
Poplarville Miss
(mailing address)

WELL LOCATION:
sec. 4 T 2 N/S R 18 E/W
1 (distance) miles 3 (direction) of Coxrd (nearest town)

WELL PURPOSE: Fish Pond
(home, irrigation, municipal, industrial)

WELL COMPLETION DATA:

(1) diameter (inches) 4

(2) total depth (feet)

(3) static water level (feet) below/above top of ground.

(4) casing PVC (material), 600 (depth),
(size) if telescope see back.

(5) screen 20 (length), 580 (depth to top)
12 (size), PVC (material)

(6) pump (HP) (yield gpm)
(type power)

(7) electric log no (yes or no)
(organization running log)

(8) how well bottom plugged Sand Shale

DRILLERS REMARKS:

description of formations encountered	from	to
Red Shale	0	10
Red Sandrock	10	65
Blue Shale	65	120
White Sand	120	145
Blue Shale	145	540
Gray Sand	540	600

RECEIVED
JUN 7 1991
Dept. of Environmental Quality
Bureau of Land & Water Resources

If well telescopes please sketch and show depths.

GROUND LEVEL

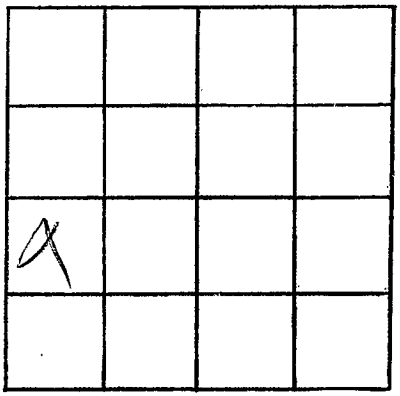

SECTION _____

Please indicate well location X.

ADDITIONAL INFORMATION

If more than one screen, show locations of each on sketch.