PEARL RIVER
F11
9-15-70

MISSISSIPPI
BOARD OF WATER COMMISSIONERS
416 North State Street
Jackson, Mississippi 39201

CODED

WATER WELL DRILLERS LOG

9-15 1970 Horace Arpole Pearl River
date well completed — firm name — county well located

LANDOWNER: C. Peters
RT #3
Poplarville Miss
(mailing address)

WELL LOCATION:
sec 35 T 2 N S R 16 E W
4 miles SW of Poplville
(distance) (direction) (nearest town)

WELL PURPOSE: Home
(home, irrigation, municipal, industrial)

WELL COMPLETION DATA:

(1) diameter (inches) 4"
(2) total depth (feet) 263
(3) static water level (feet) 200 below above top of ground.
(4) casing Galv (material), 252 (depth), 2" (size) if telescope see back.
(5) screen 10 (length), 252 (depth to top), 2 (size), PVC (material)
(6) pump 3/4 Rod Pump (HP) 160 (yield gpm) Elec (type power)
(7) electric log no (yes or no)
(organization running log)
(8) how well bottom plugged BACKWASH VALVE

DRILLERS REMARKS:

description of formations encountered	from	to
Pipe Clay	0	252
Sand	252	~~245~~ 263

CODED

SEP 18 1970
MISS. BD. OF WATER COMM.

If well telescopes please sketch and show depths.

GROUND LEVEL

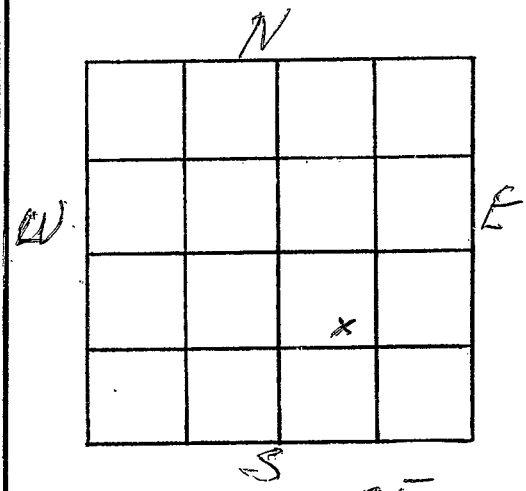

SECTION 35

Please indicate well location X.

ADDITIONAL INFORMATION

If more than one screen, show locations of each on sketch.