G 48

35/01 ~~257~~

MISSISSIPPI DEPARTMENT OF NATURAL RESOURCES

Bureau of Land and Water Resources

P.O. Box 10631
Jackson, Mississippi 39209

WATER WELL DRILLERS LOG

COUNTY WELL LOCATED: Pearl River	
WELL NUMBER: No. 1 Fenix Minerals	CODED: CODED
PERMIT NUMBER	
NAME OF DRILLING FIRM: Griner Drilling Service, Inc.	
DATE WELL COMPLETED: 2-14-89	

NAME & MAILING ADDRESS OF LANDOWNER
Union Exploration Partners
P.O. Box 160628
Mobile, Ala. 36616

WELL LOCATION: SEC 17 TOWNSHIP 2 N (S) RANGE 15 E (W)

DISTANCE: 1500'N & 1500' E of SW cor. Miles of NEAREST TOWN

OTHER LANDMARK: Poplarville

WELL PURPOSE: Home, Irrigation, Municipal, Industrial, Fish Pond, etc.
Oilfield Rig Supply

PUMP DATA

PUMP TYPE (Circle One): Submersible, Turbine, Jet, Flowing Well, Other (Describe) Air lift

POWER TYPE (Circle One): Electric, Tractor, Diesel, Gasoline, Butane, Other (Describe) Well

Pump Capacity (GPM)	No. of Stages	Setting Depth
		FT.

PUMP TEST

Well yielded 75-80 GPM with a drawdown of — ft. after 3-4 hours of pumping

WELL DATA

Well Depth	Casing Diameter (In.)	Casing Length (Ft.)
530'	3"	488'

Type of Casing	Hole Depth	Depth to Static Water Level
Steel	530'	55'

TYPE OF COMPLETION: (Circle One or More): Gravel Packed, Underreamed, Telescoped, Natural Development, Open Hole, Other (Describe)

Top of Lap Pipe or Reduction in Casing: FEET

IF TELESCOPED OR MORE THAN ONE SCREEN: USE BACK PAGE

LOG DATA

TYPE OF LOG RUN (Circle One): No Log Run, Electric, Gamma Ray, Density, Sonic, Neutron, Other (Describe)

Name of Organization Running Log

GEOLOGIC DATA (Office Use Only)

Surface Elev.	Geologic Unit	Unit Thickness	Depth to Top
Subs. SWL	Date	Analysis	Aquifer Test

Driller's Remarks

SCREEN DATA

Diameter - Inches	Length - Feet	Slot Size - Inches
3"	42'	.010

Screen Type	Depth to Bottom - Feet
Perforated Slot	488'-530'

DESCRIPTION OF FORMATIONS ENCOUNTERED	FROM	TO
Clay	0	420
Sand	420	530

FORMATIONS (Continued)	FROM	TO

IF MORE SPACE IS NEEDED, USE BACK

RECEIVED
FEB 28 1989
Department of Natural Resources
Bureau of Land & Water Resources

If well telescopes please
sketch and show depths.

GROUND LEVEL

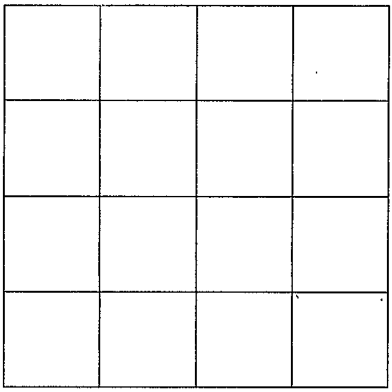

SECTION _____

Please indicate well location X.

ADDITIONAL INFORMATION

If more than one screen,
show location of each on sketch.