MISSISSIPPI BOARD OF WATER COMMISSIONERS

Pearl R.
G2991
1-11-65

WATER WELL DRILLERS LOG

Date: 1-11, 1965, Driller: Sutter Well Works County Pearl River
(Name)

(1) Owner of Land: Gordon Williams
(Name)
Poplarville, Miss.
(Address)

(2) Location: NE ¼, SW ¼, Sec. 32 T 2S R 15W
1 miles (distance) S (direction) of Poplarville (Nearest Town)

(3) Topography: Hilly (Hilly) (Flat) (Level)

(4) Purpose of Well: Sub-division
(Domestic Irrigation Municipal, Industrial, Other)

Information upon completion of well:

(1) Diameter 4 inches.

(2) Total Depth 570 feet.

(3) Water Level 187 feet below top of ground.

(4) Cased to all, Size 4",

(5) Screen: Size 4", Length 20'.

(6) Were any formations sealed against pollution?

_____ yes, _____ no.

If YES depth of formation _____,

Why _____

Drillers Remarks: _____

Description & Color of Materials Sand, Clay, Red Clay, Shell, etc.	Thickness Feet	Depth Feet
Clay	23	23
Sand	50	73
Clay	87	160
Sand	9	169
Clay	26	195
Sand	57	252
Clay	218	470
Sand	100	570

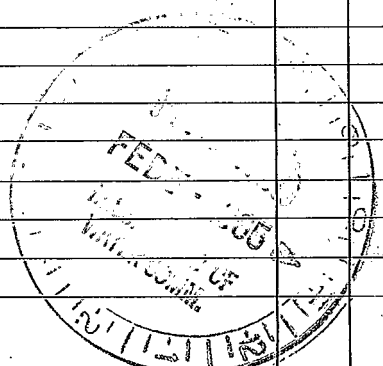

(Use Back Side)

Well No.

Mail this copy to Board of Water Commissioners 429 Miss. St. Jackson, Miss.