MISSISSIPPI DEPARTMENT OF ENVIRONMENTAL QUALITY
Office of Land and Water Resources

P. O. Box 10631
Jackson, MS 39289-0631
WATER WELL DRILLERS LOG

COUNTY WELL LOCATED: Pearl River	
WELL NUMBER: G-2055	CODED:
DATE WELL COMPLETED: 9-28-00	
PERMIT NUMBER:	
NAME OF DRILLING FIRM: Boone's Water Well	

NAME & MAILING ADDRESS OF LANDOWNER
Jennifer Stanford
281 Shenandoah Rd
Poplarville, MS 39470

WELL LOCATION: SEC 22 TOWNSHIP 2 N (S) RANGE 15 E (W)

DISTANCE 3 Miles DIRECTION E NEAREST TOWN of Poplarville

OTHER LANDMARK

WELL PURPOSE: (Home), Irrigation, Municipal, Industrial, Fish Pond, etc.

PUMP DATA

PUMP TYPE (Circle One): (Submersible), Turbine, Jet Flowing Well, Other (Describe) _____

POWER TYPE (Circle One): (Electric), Tractor, Diesel, Gasoline, Butane, Other (Describe) _____ H/P 1

Pump Capacity (GPM)	No. of Stages	Setting Depth
20		FT.

PUMP TEST

Well yielded _____ GPM with a drawdown of _____ ft. after _____ hours of pumping

WELL DATA

Well Depth	Casing Diameter (In.)	Casing Length (Ft.)
180	4	160

Type of Casing	Hole Depth	Depth to Static Water Level
Sch40	180	

TYPE OF COMPLETION: (Circle One or More): (Gravel Packed), Underreamed, Telescoped, Natural Development, Open Hole, Other (Describe) _____

WELL GROUTED TO A DEPTH OF 10 FEET
Type Grout (circle one): (Cement), Bentonite, or Mix

LOG DATA

TYPE OF LOG RUN (Circle One): No Log Run, Electric, Gamma Ray, Density, Sonic, Neutron, Other (Describe) _____

Name of Organization Running Log

GEOLOGIC DATA (Office Use Only)

Surface Elev.	Geologic Unit	Unit Thickness	Depth to Top
Subs. SWL	Date	Analysis	Aquifer Test

Driller's Remarks

SCREEN DATA

Diameter - Inches	Length - Feet	Slot Size - Inches
4	20	#8

Screen Type	Depth to Bottom - Feet
Sch40	

Top of Lap Pipe or Reduction in Casing
FEET — IF TELESCOPED OR MORE THAN ONE SCREEN: USE BACK PAGE

DESCRIPTION OF FORMATIONS ENCOUNTERED	FROM	TO	FORMATIONS (Continued)	FROM	TO
Sand	0	45			
Clay	45	140			
Sand	140	180			
			IF MORE SPACE IS NEEDED, USE BACK		

REC'D AUG 24 2001

If well telescopes please
sketch and show depths.

GROUND LEVEL

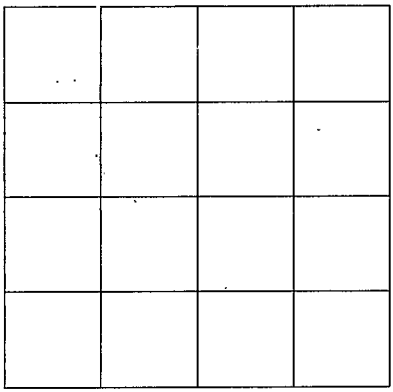

SECTION _____

Please indicate well location X.

ADDITIONAL INFORMATION

If more than one screen,
show location of each on sketch.