MISSISSIPPI DEPARTMENT OF ENVIRONMENTAL QUALITY
Office of Land and Water Resources
P. O. Box 10631
Jackson, MS 39289-0631

WATER WELL DRILLERS LOG

COUNTY WELL LOCATED	Pearl River
WELL NUMBER	H-20666
CODED	
PERMIT NUMBER	
NAME OF DRILLING FIRM	Moores Water Well Service
	31 R. Moore Rd, Wiggins, MS
DATE WELL COMPLETED	7-13-00

NAME & MAILING ADDRESS OF LANDOWNER
Frank Delaney
2673 Hiway 26 East
Lumberton, MS 39455

WELL LOCATION: SEC 23 TOWNSHIP 2 S RANGE 14 W

DISTANCE 2 Miles DIRECTION from ~~NEAREST TOWN~~ of Lake Tokaleen

OTHER LANDMARK
Lake Tokaleen

WELL PURPOSE: Home, Irrigation, Municipal, Industrial, Fish Pond, etc.

PUMP DATA

PUMP TYPE (Circle One): Submersible, Turbine, Jet, Flowing Well, Other (Describe) _____

POWER TYPE (Circle One): Electric, Tractor, Diesel, Gasoline, Butane, Other (Describe) _____ H/P _____

Pump Capacity (GPM)	No. of Stages	Setting Depth
		FT.

PUMP TEST
Well yielded _____ GPM with a drawdown of _____ ft. after _____ hours of pumping

WELL DATA

Well Depth	Casing Diameter (In.)	Casing Length (Ft.)
190'	2"	180'
Type of Casing	**Hole Depth**	**Depth to Static Water Level**
PVC	190'	100'

TYPE OF COMPLETION: (Circle One or More): Gravel Packed, Underreamed, Telescoped, Natural Development, Open Hole, Other (Describe) _____

WELL GROUTED TO A DEPTH OF 10 FEET
Type Grout (circle one): Cement, Bentonite, or Mix

LOG DATA

TYPE OF LOG RUN (Circle One): No Log Run, Electric, Gamma Ray, Density, Sonic, Neutron, Other (Describe) _____

Name of Organization Running Log

GEOLOGIC DATA (Office Use Only)

Surface Elev.	Geologic Unit	Unit Thickness	Depth to Top
Subs. SWL	Date	Analysis	Aquifer Test

Driller's Remarks

SCREEN DATA

Diameter - Inches	Length - Feet	Slot Size - Inches
2"	10'	.08
Screen Type		**Depth to Bottom - Feet**
PVC sch 40		190'

Top of Lap Pipe or Reduction in Casing
FEET (IF TELESCOPED OR MORE THAN ONE SCREEN, USE BACK PAGE)

DESCRIPTION OF FORMATIONS ENCOUNTERED	FROM	TO	FORMATIONS (Continued)	FROM	TO
topsoil	1'	2'			
red clay	2'	20'			
red soapstone	20'	30'			
red sand & gravel	30'	50'			
white soapstone	50'	80'			
Brown soap Stone	80'	160'			
White Sand & gravel	160'	190'			
			IF MORE SPACE IS NEEDED, USE BACK		

RECEIVED
JUL 28 2000
Dept. of Environmental Quality
Office of Land & Water Resources

If well telescopes please
sketch and show depths.

GROUND LEVEL

 

If more than one screen,
show location of each on sketch.

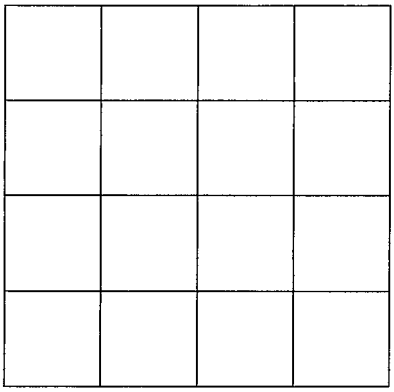

SECTION _____

Please indicate well location X.

ADDITIONAL INFORMATION