

MISSISSIPPI DEPARTMENT OF NATURAL RESOURCES

Bureau of Land and Water Resources

Southport Mall

P.O. Box 10631

Jackson, Mississippi 39209

WATER WELL DRILLERS LOG

CODED

Griner Drilling Service, Inc.

Pearl River

PEARL RIVER  
K 64  
7-2-86

7-2-86  
date well completed

Griner Drilling Service, Inc.  
firm name

Pearl River  
county well located

LANDOWNER:

EXXON CO., U.S.A.  
P.O. Box 60006  
New Orleans, La. 70160  
(mailing address)

description of formations encountered

from

to

TOP SOIL

0 10

SAND

10 30

CLAY

30 105

SAND

105 147

CLAY

147 250

SAND

250 315

CLAY

315 336

WELL LOCATION: 1506 541700 W  
sec. 13 T 3 N R 17 E OF  
No. 1 Koch at J.F. miles Poplarville Field  
(distance) (direction) (nearest town)

WELL PURPOSE: Oilfield rig  
(home, irrigation, municipal, industrial)

WELL COMPLETION DATA:

(1) diameter (inches) 4"

(2) total depth (feet) 336'

(3) static water level (feet) 15' below top of ground.

(4) casing steel 315'  
(material) (depth)

4 1/2" if telescope see back.  
(size)

(5) screen 42' 273'  
(length) (depth to top)

4" perforated  
(size) (material)

(6) pump — 70  
(HP) (yield gpm)

AC  
(type power)


(7) electric log (yes or no)

(organization running log)

(8) how well bottom plugged orange  
peel

DRILLERS REMARKS:


WATER Well 1 No. 1

 

Department of Natural Resources  
Bureau of Land and Water Resources

If well telescopes please sketch and show depths.

GROUND LEVEL

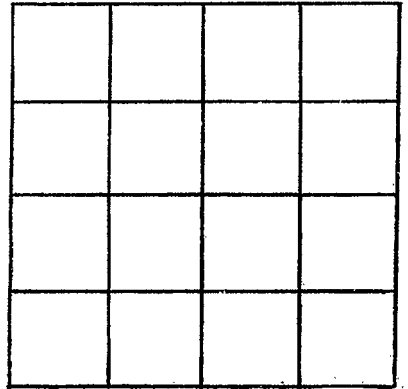

SECTION \_\_\_\_\_

Please indicate well location X.

ADDITIONAL INFORMATION

If more than one screen,  
show locations of each on sketch.