Pearl River
D 2065

MISSISSIPPI DEPARTMENT OF NATURAL RESOURCES
Bureau of Land and Water Resources
Southport Mall
P.O. Box 10631
Jackson, Mississippi 39209

WATER WELL DRILLERS LOG

9-20-83 (date well completed) 19 Walker's Welding and Repair (firm name) Pearl River (county well located)

LANDOWNER: Richard Duncan
Rt 1 Box 227C
Carriere Ms
(mailing address)

WELL LOCATION:
sec. 39 T 4 N/S R 18 E/W
14 (distance) miles NE (direction) of Picayune (nearest town)

WELL PURPOSE: Home
(home, irrigation, municipal, industrial)

WELL COMPLETION DATA:

(1) diameter (inches) 2

(2) total depth (feet) 60

(3) static water level (feet) 30 below ~~above~~ top of ground.

(4) casing PVC (material), 50 (depth),
_____ (size) if telescope see back.

(5) screen 10 (length), 50 (depth to top)
12 (size), PVC (material)

(6) pump ½ (HP) 7 (yield gpm)
Electric (type power)

(7) electric log no (yes or no)
_____ (organization running log)

(8) how well bottom plugged
Sand Shark

DRILLERS REMARKS:

description of formations encountered	from	to
Red Clay	0	10
Fine Sand	10	20
Coarse Sand	20	25
Red Clay	25	35
Coarse Sand	35	60

DEPT. OF NATURAL RESOURCES
BUREAU OF LAND & WATER RESOURCES
OCT 10 1983
RECEIVED

If well telescopes please sketch and show depths.

GROUND LEVEL

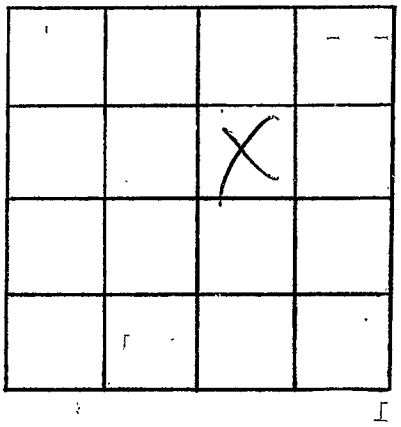

SECTION _____

Please indicate well location X.

ADDITIONAL INFORMATION

If more than one screen, show locations of each on sketch.