MISSISSIPPI DEPARTMENT OF NATURAL RESOURCES

Bureau of Land and Water Resources

P.O. Box 10631
Jackson, Mississippi 39209
WATER WELL DRILLERS LOG

COUNTY WELL LOCATED: Pearl River

WELL NUMBER: Ø | CODED:

2104

DATE WELL COMPLETED: 10-25-86

PERMIT NUMBER: 0428

NAME OF DRILLING FIRM: Walker Well Drilling

NAME & MAILING ADDRESS OF LANDOWNER: Daniel Core

WELL LOCATION: SEC 23 TOWNSHIP 4 N (S) RANGE 18 E (W)

DISTANCE 17 Miles DIRECTION NW of NEAREST TOWN PICAYUNE

OTHER LANDMARK:

WELL PURPOSE: Home, Irrigation, Municipal, Industrial, Fish Pond, etc.: HOME

PUMP DATA

PUMP TYPE (Circle One): Submersible, Turbine, (Jet) Flowing Well, Other (Describe) #12

POWER TYPE (Circle One): (Electric) Tractor, Diesel, Gasoline, Butane, Other (Describe)

Pump Capacity (GPM)	No. of Stages	Setting Depth
8	2	60 FT.

PUMP TEST

Well yielded _____ GPM with

a drawdown of _____ ft.

after _____ hours of pumping

WELL DATA

Well Depth	Casing Diameter (In.)	Casing Length (Ft.)
80'	2"	70'

Type of Casing	Hole Depth	Depth to Static Water Level
PVC	82'	60'

TYPE OF COMPLETION: (Circle One or More): ~~Gravel Packed,~~ Underreamed, Telescoped, (Natural Development), Open Hole, Other (Describe) AIR

Top of Lap Pipe or Reduction in Casing: FEET

IF TELESCOPED OR MORE THAN ONE SCREEN: USE BACK PAGE

LOG DATA

TYPE OF LOG RUN (Circle One): No Log Run, Electric, Gamma Ray, Density, Sonic, Neutron, Other (Describe)

Name of Organization Running Log

GEOLOGIC DATA (Office Use Only)

Surface Elev.	Geologic Unit	Unit Thickness	Depth to Top
Subs. SWL	Date	Analysis	Aquifer Test

Driller's Remarks

SCREEN DATA

Diameter - Inches	Length - Feet	Slot Size - Inches
2"	10'	10#

Screen Type	Depth to Bottom - Feet
#10 SLOT	80'

RECEIVED
NOV 20 1986
Department of Natural Resources
Bureau of Land & Water Resources

DESCRIPTION OF FORMATIONS ENCOUNTERED	FROM	TO
RED CLAY	0	10
RED SAND	10	20
WHITE CLAY	20	25
WHITE SAND	25	80

FORMATIONS (Continued)	FROM	TO

IF MORE SPACE IS NEEDED, USE BACK

If well telescopes please
sketch and show depths.

GROUND LEVEL

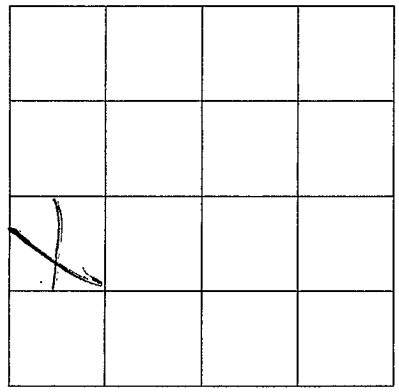

SECTION _____

Please indicate well location X.

ADDITIONAL INFORMATION

If more than one screen,
show location of each on sketch.