MISSISSIPPI DEPARTMENT OF NATURAL RESOURCES

Bureau of Land and Water Resources

P.O. Box 10631
Jackson, Mississippi 39209

WATER WELL DRILLERS LOG

COUNTY WELL LOCATED: Pearl River	
WELL NUMBER: Q 2190	CODED:
DATE WELL COMPLETED: 4-5-96	
PERMIT NUMBER:	
NAME OF DRILLING FIRM: Walker's Welding & Repair	

NAME & MAILING ADDRESS OF LANDOWNER
Don Hendrix
Rt 1
Carriere, Miss

WELL LOCATION: SEC 39 TOWNSHIP 4 N (S) RANGE 18 E (W)

DISTANCE 14 Miles DIRECTION S of NEAREST TOWN Picayune

OTHER LANDMARK

WELL PURPOSE: (Home) Irrigation, Municipal, Industrial, Fish Pond, etc.

PUMP DATA

PUMP TYPE (Circle One): (Submersible) Turbine, Jet Flowing Well, Other (Describe) _____

POWER TYPE (Circle One): (Electric) Tractor, Diesel, Gasoline, Butane, Other (Describe) _____

Pump Capacity (GPM)	No. of Stages	Setting Depth
10		280 FT.

PUMP TEST

Well yielded _____ GPM with

a drawdown of _____ ft.

after _____ hours of pumping

WELL DATA

Well Depth	Casing Diameter (In.)	Casing Length (Ft.)
330'	4"	310'

Type of Casing	Hole Depth	Depth to Static Water Level
PVC	330'	200'

TYPE OF COMPLETION: (Circle One or More): (Gravel Packed) Underreamed, Telescoped, Natural Development, Open Hole, Other (Describe) _____

Top of Lap Pipe or Reduction in Casing

FEET

IF TELESCOPED OR MORE THAN ONE SCREEN: USE BACK PAGE

SCREEN DATA

Diameter - Inches	Length - Feet	Slot Size - Inches
4"	20'	.010

Screen Type	Depth to Bottom - Feet
PVC	

LOG DATA

TYPE OF LOG RUN (Circle One): No Log Run, Electric, Gamma Ray, Density, Sonic, Neutron, Other (Describe) _____

Name of Organization Running Log

GEOLOGIC DATA (Office Use Only)

Surface Elev.	Geologic Unit	Unit Thickness	Depth to Top
Subs. SWL	Date	Analysis	Aquifer Test

Driller's Remarks

DESCRIPTION OF FORMATIONS ENCOUNTERED	FROM	TO	FORMATIONS (continued)	FROM	TO
			IF MORE SPACE IS NEEDED, USE BACK		

RECEIVED
APR 19 1996
Dept. of Environmental Quality
Office of Land & Water Resources

If well telescopes please
sketch and show depths.

GROUND LEVEL

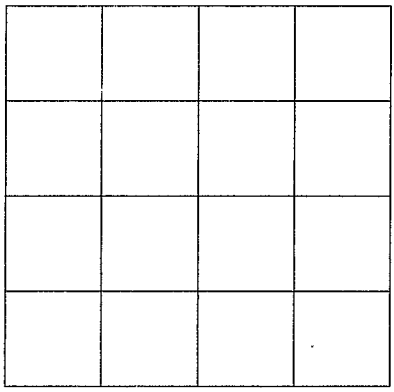

SECTION _____

Please indicate well location X.

ADDITIONAL INFORMATION

If more than one screen,
show location of each on sketch.