

P 2002  
8-26-64

WATER WELL DRILLERS LOG

Date: 8-26-, 1964, Driller: Sutter Well Works County Pearl River  
(Name)

(1) Owner of Land: La Rou Investment  
(Name)  
Picayune Miss.  
(Address)  
(2) Location: NE 1/4, SW 1/4, Sec. 20 T45R17W  
6 miles W, of McNeill  
(distance) (direction) (Nearest Town)  
(3) Topography: Hilly  
(Hilly) (Flat) (Level)  
(4) Purpose of Well: domestic  
(Domestic Irrigation  
Municipal, Industrial, Other)


Description & Color of Materials Sand, Clay, Red Clay, Shell, etc.	Thick- ness Feet	Depth Feet
<u>Clay - sand streaks</u>	<u>86</u>	<u>86</u>
<u>Clay</u>	<u>61</u>	<u>147</u>
<u>Clay - sand streaks</u>	<u>107</u>	<u>254</u>
<u>Sand - gravel</u>	<u>61</u>	<u>315</u>

Information upon completion of well:

(1) Diameter 4 inches.  
(2) Total Depth 315 feet.  
(3) Water Level 126 feet below top of ground.  
(4) Cased to all, Size 4"  
(5) Screen: Size 4", Length 15'  
(6) Were any formations sealed against pollution?  
no yes,  no.

If YES depth of formation \_\_\_\_\_  
Why \_\_\_\_\_

Drillers Remarks: \_\_\_\_\_  
\_\_\_\_\_  
\_\_\_\_\_

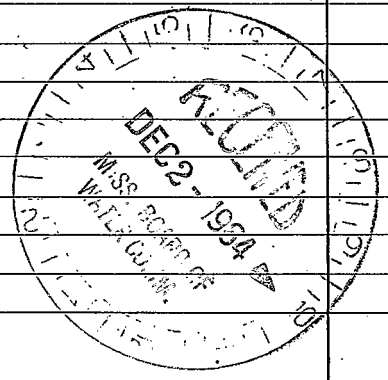

(Use Back Side)

Well No.










