MISSISSIPPI DEPARTMENT OF NATURAL RESOURCES

Bureau of Land and Water Resources

P.O. Box 10631
Jackson, Mississippi 39209
WATER WELL DRILLERS LOG

COUNTY WELL LOCATED: PEARL RIVER	
WELL NUMBER: P	CODED:
2081	
DATE WELL COMPLETED: 4-6-88	
PERMIT NUMBER: 0428	
NAME OF DRILLING FIRM: WALKER'S WELL SERVICES	

NAME & MAILING ADDRESS OF LANDOWNER
CURTIS CAMBELL
Rt. 1 Carriere MISS

WELL LOCATION: SEC 13 TOWNSHIP 4 N (S) RANGE 17 E (W)

DISTANCE 15 Miles DIRECTION N of NEAREST TOWN PICAYUNE

OTHER LANDMARK
HENLEFEILD

WELL PURPOSE: (Home) Irrigation, Municipal, Industrial, Fish Pond, etc.

PUMP DATA

PUMP TYPE (Circle One):
Submersible, Turbine, Jet Flowing Well,
Other (Describe) _____

POWER TYPE (Circle One):
Electric, Tractor, Diesel, Gasoline, Butane,
Other (Describe) _____

Pump Capacity (GPM)	No. of Stages	Setting Depth
		FT.

PUMP TEST

Well yielded _____ GPM with

a drawdown of _____ ft.

after _____ hours of pumping

WELL DATA

Well Depth	Casing Diameter (In.)	Casing Length (Ft.)
31'	2"	21'
Type of Casing	**Hole Depth**	**Depth to Static Water Level**
PVC	35'	22'

TYPE OF COMPLETION: (Circle One or More):
Gravel Packed, Underreamed, Telescoped,
(Natural Development), Open Hole, Other
(Describe) AIR

Top of Lap Pipe or Reduction in Casing
FEET

IF TELESCOPED OR MORE THAN ONE SCREEN: USE BACK PAGE

LOG DATA

TYPE OF LOG RUN (Circle One): No Log Run,
Electric, Gamma Ray, Density, Sonic, Neutron,
Other (Describe) _____

Name of Organization Running Log

GEOLOGIC DATA (Office Use Only)

Surface Elev.	Geologic Unit	Unit Thickness	Depth to Top
Subs. SWL	Date	Analysis	Aquifer Test

Driller's Remarks

SCREEN DATA

Diameter - Inches	Length - Feet	Slot Size - Inches
2"	10'	#10
Screen Type	**Depth to Bottom - Feet**	
SLOT	31'	

DESCRIPTION OF FORMATIONS ENCOUNTERED	FROM	TO
RED CLAY	0	10
SANDY RED CLAY	10	15
SAND + ROCKS	15	31'

FORMATIONS (Continued)	FROM	TO

RECEIVED
APR 15 1988
Department of Natural Resources
Bureau of Land & Water Resources

IF MORE SPACE IS NEEDED, USE BACK

If well telescopes please
sketch and show depths.

GROUND LEVEL

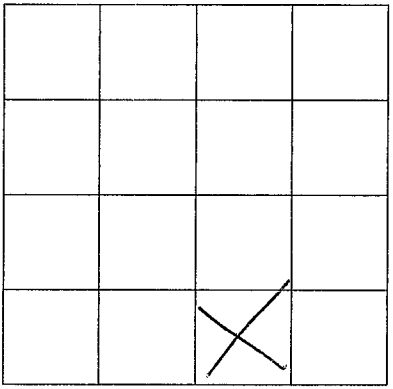

SECTION _____

Please indicate well location X.

ADDITIONAL INFORMATION

If more than one screen,
show location of each on sketch.