MISSISSIPPI DEPARTMENT OF NATURAL RESOURCES

Bureau of Land and Water Resources

P.O. Box 10631
Jackson, Mississippi 39209

WATER WELL DRILLERS LOG

COUNTY WELL LOCATED: Pearl River

WELL NUMBER: P 2146 | CODED:

DATE WELL COMPLETED: 8-7-96

PERMIT NUMBER:

NAME OF DRILLING FIRM: Walkers Welding & Repair

NAME & MAILING ADDRESS OF LANDOWNER:
Richard Hughes
224 Wind Oaks Rd
Carriere, Miss 39426

WELL LOCATION: SEC 7 TOWNSHIP 4 N (S) RANGE 17 E (W)

DISTANCE 14 Miles DIRECTION N of NEAREST TOWN Picayune

OTHER LANDMARK:

WELL PURPOSE: (Home) Irrigation, Municipal, Industrial, Fish Pond, etc.

PUMP DATA

PUMP TYPE (Circle One): (Submersible,) Turbine, Jet Flowing Well, Other (Describe) ____

POWER TYPE (Circle One): (Electric) Tractor, Diesel, Gasoline, Butane, Other (Describe) ____

Pump Capacity (GPM)	No. of Stages	Setting Depth
10	-	75 FT.

PUMP TEST

Well yielded ____ GPM with a drawdown of ____ ft. after ____ hours of pumping

WELL DATA

Well Depth	Casing Diameter (In.)	Casing Length (Ft.)
432'	4" X 2"	412'

Type of Casing	Hole Depth	Depth to Static Water Level
PVC	432'	55'

TYPE OF COMPLETION: (Circle One or More): Gravel Packed, Underreamed, Telescoped, (Natural Development,) Open Hole, Other (Describe) ____

Top of Lap Pipe or Reduction in Casing: FEET

IF TELESCOPED OR MORE THAN ONE SCREEN: USE BACK PAGE

LOG DATA

TYPE OF LOG RUN (Circle One): No Log Run, Electric, Gamma Ray, Density, Sonic, Neutron, Other (Describe) ____

Name of Organization Running Log:

GEOLOGIC DATA (Office Use Only)

Surface Elev.	Geologic Unit	Unit Thickness	Depth to Top
Subs. SWL	Date	Analysis	Aquifer Test

Driller's Remarks:

SCREEN DATA

Diameter - Inches	Length - Feet	Slot Size - Inches
2"	20'	.010

Screen Type	Depth to Bottom - Feet
PVC	432'

RECEIVED
SEP 03 1996
Dept. of Environmental Quality
Office of Land & Water Resources

DESCRIPTION OF FORMATIONS ENCOUNTERED	FROM	TO
Black Top Soil	0	8'
Red Sandy Clay	8'	36'
Blue Clay	36'	108'
Sand & Black Rock	108'	150'
Blue Clay	150'	396'
Coarse Sand & Black Rock	396'	432'

FORMATIONS (Continued)	FROM	TO

IF MORE SPACE IS NEEDED, USE BACK

If well telescopes please
sketch and show depths.

GROUND LEVEL

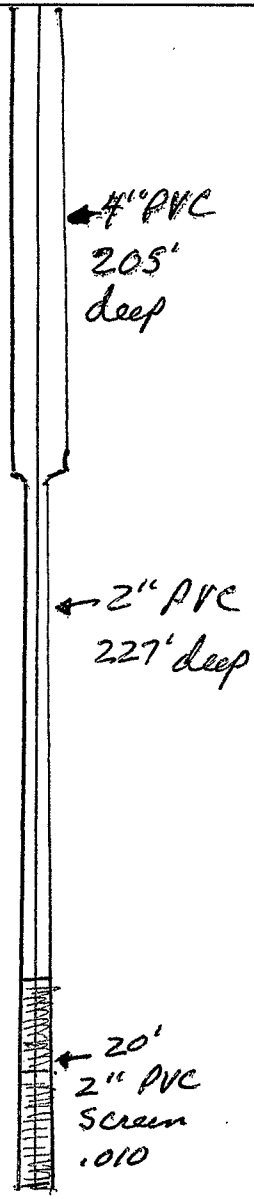

If more than one screen,
show location of each on sketch.

	X		

SECTION 7

Please indicate well location X.

ADDITIONAL INFORMATION