

Pearl R.
Q-13
8-7-62

WATER WELL DRILLERS LOG

Date: Aug 7, 1962, Driller: POUPART
9751 9867 (Name)

County PEARL RIVER

CODED

(1) Owner of Land: MRS. BAUCOM

(Name)

M^cNeill Miss.

(Address)

33 4/16

(2) Location: 1/4, 1/4, Sec. 4-15-22

4 miles EAST of M^cNeill
(distance) (direction) (Nearest Town)

(3) Topography: (Hilly) (Flat) (Level)

(4) Purpose of Well: DOMESTIC

(Domestic Irrigation
Municipal, Industrial, Other)

Description & Color of Materials
Sand, Clay, Red Clay, Shell, etc.

Thick-
ness
Feet

Depth
Feet

SAND + CLAY
Red

20 20

SAND + GRAVEL

10 30

BLUE GLAY

60 90

Good SAND

Grey Blue

20 110

Information upon completion of well:

(1) Diameter 2 inches.

(2) Total Depth 110 feet.

(3) Water Level 30 feet below top of ground.

(4) Cased to _____, Size _____

(5) Screen: Size 8, Length 4'

(6) Were any formations sealed against pollution?

_____ yes, _____ no.


If YES depth of formation _____

Why _____

Drillers Remarks: Good SAND

Grey.

CODED

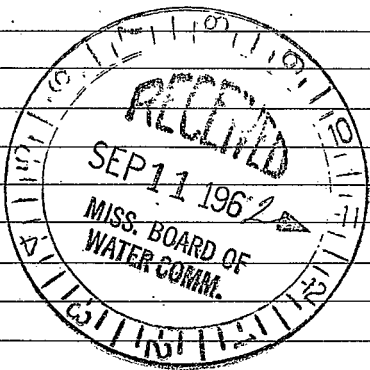

(Use Back Side)

Well No.




