P.R.
Q24
6-17-74

MISSISSIPPI
BOARD OF WATER COMMISSIONERS
416 North State Street
Jackson, Mississippi 39201

CODED
Pearl River

WATER WELL DRILLERS LOG

6-17 1974 Earl R. Paston water well Serv.
date well completed — firm name — county well located

LANDOWNER: Crowizeller Back
Box 260 Bogalusa LA
(mailing address)

WELL LOCATION:
sec. 4 T 4 N/S R 16 E/W 13V
½ miles west of Millard
(distance) (direction) (nearest town)

WELL PURPOSE: Industrial
(home, irrigation, municipal, industrial)

WELL COMPLETION DATA:
(1) diameter (inches) 7⅝
(2) total depth (feet) 280'
(3) static water level (feet) 78 below/above top of ground
(4) casing P.V.C., 260,
(material), (depth)
(size) if telescope see back.
(5) screen 20', 260
(length), (depth to top)
4", P.V.C.
(size), (material)
(6) pump 1 900 P.A.
(HP) (yield gpm)
Elect
(type power)
(7) electric log NO
(yes or no)
(organization running log)
(8) how well bottom plugged Sand

DRILLERS REMARKS:

description of formations encountered	from	to
Red Clay	0	14
White Clay	14	22
Blue Clay	22	130
Medium yellow Sd.	130	160
Blue Clay	160	170
Fine Gray Sd.	170	230
Gray coarse Sd.	230	280

RECEIVED
FEB 18 1975
MISS. BD. OF WATER COMM.

D

If well telescopes please sketch and show depths.

GROUND LEVEL

If more than one screen, show locations of each on sketch.

Fire tower

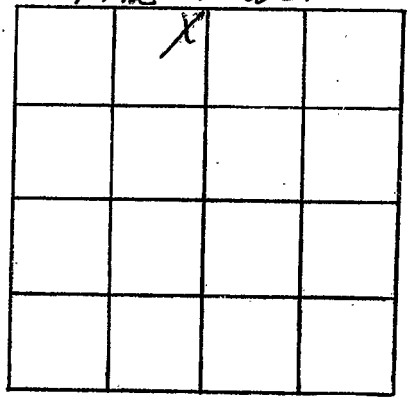

SECTION _____

Please indicate well location X.

ADDITIONAL INFORMATION