

Pearl R.

MISSISSIPPI BOARD OF WATER COMMISSIONERS

S-2

3-61

WATER WELL DRILLERS LOG

(?)

Date: Mar, 1961, Driller: Les Leber (Name) Jefferson (County)

CODED

(1) Owner of Land: J.A. Courtney
 (Name)
Rt 2 Poplarville Miss
 (Address)

(2) Location: 1/4, 1/4, Sec. 15 T4 R14,
16 miles SE of Poplarville
 (distance) (direction) (Nearest Town)

(3) Topography: (Hilly) (Flat) (Level)

(4) Purpose of Well: Home use
 (Domestic Irrigation
 Municipal, Industrial, Other)

| Description & Color of Materials Sand, Clay, Red Clay, Shell, etc. | Thick- ness Feet | Depth Feet |
|---|------------------------|----------------|
| <u>Sand Clay</u> | <u>20</u> | |
| <u>Red + White Clay</u> | <u>27</u> | <u>47</u> |
| <u>Sand</u> | <u>4</u> | <u>51</u> |
| <u>White Clay</u> | <u>64</u> | <u>115</u> |
| <u>Blue Clay</u> | | <u>112-225</u> |
| <u>Blue Sand</u> | | <u>32-257</u> |

Information upon completion of well:

(1) Diameter 2 inches.


(2) Total Depth 257 feet.

(3) Water Level 100 feet below top of ground.

(4) Cased to 257, Size 2 1/2

(5) Screen: Size 008, Length 5'

(6) Were any formations sealed against pollution?
 yes, no.

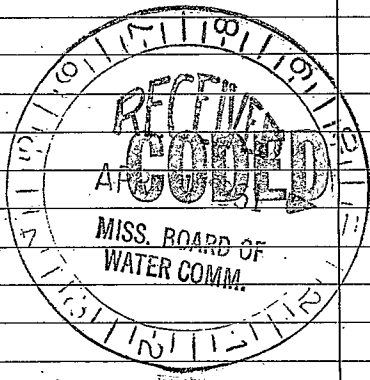

If YES depth of formation _____

Why _____

Drillers Remarks: _____

54

Well No.

(Use Back Side)





