Pearl River
T 16
6-19-73

# MISSISSIPPI
## BOARD OF WATER COMMISSIONERS
416 North State Street
Jackson, Mississippi 39201

CODED

## WATER WELL DRILLERS LOG

6-19 1973 Lumpkin Well Ser. Pearl River
date well completed — firm name — county well located

LANDOWNER: Danial Burks
Rt.
Picayune, Miss.
(mailing address)

WELL LOCATION:
sec. 24 T 5 N (S) R 18 E (W)
5 miles N.W of Picayune
(distance) (direction) (nearest town)

WELL PURPOSE: Home
(home, irrigation, municipal, industrial)

WELL COMPLETION DATA:
(1) diameter (inches) 2"
(2) total depth (feet) 1015
(3) static water level (feet) 20' below above top of ground.
(4) casing Gal. (material), 984' (depth), 2" (size) If telescope see back. 985
(5) screen 21' (length), 984' (depth to top), 2" (size), S.S. (material)
(6) pump No (HP) (yield gpm)
No (type power)
(7) electric log No (yes or no)
(organization running log)
(8) how well bottom plugged Sand Shark

DRILLERS REMARKS:

| description of formations encountered | from | to |
|---|---|---|
| Clay | 0 | 10 |
| Sand | 10 | 90 |
| Clay | 90 | 250 |
| Sand | 250 | 355 |
| Clay | 355 | 540 |
| Sand | 540 | 580 |
| Clay | 580 | 725 |
| Sand | 725 | 740 |
| Clay | 740 | 985 |
| Good Sand | 985 | 1015 |

CODED

JUN 27 1973

MISS. BD. OF WATER COMM

If well telescopes please sketch and show depths.

GROUND LEVEL

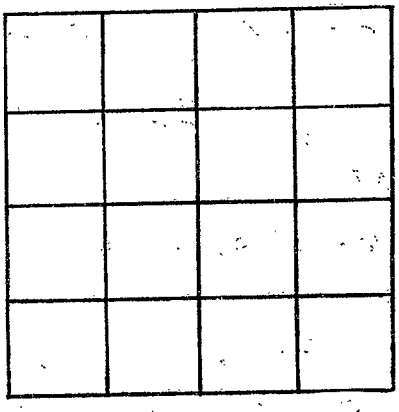

SECTION _____

Please indicate well location X.

ADDITIONAL INFORMATION

If more than one screen, show locations of each on sketch.