P. River
U 2133

MISSISSIPPI DEPARTMENT OF NATURAL RESOURCES

Bureau of Land and Water Resources
Southport Mall
P.O. Box 10631
Jackson, Mississippi 39209

WATER WELL DRILLERS LOG

7-24 19 92 — date well completed
Bud Penton Water Well — firm name
Pearl River — county well located

LANDOWNER: Jim Lambert
PO Box 419 Picayune
Ms 39466
(mailing address)

WELL LOCATION:
sec. 18 T 5 N/S R 17 E/W
2 (distance) miles East (direction) of Cybur (nearest town)

WELL PURPOSE: Home
(home, irrigation, municipal, industrial)

WELL COMPLETION DATA:

(1) diameter (inches) 7"
(2) total depth (feet) 572
(3) static water level (feet) 51' below/above top of ground.
(4) casing PVC (material), 557' (depth), 4"x2" (size) if telescope see back.
(5) screen 15 (length), 557' (depth to top), 2" (size), PVC (material)
(6) pump 2 (HP) 25 (yield gpm) electric (type power)
(7) electric log NO (yes or no)
(organization running log)
(8) how well bottom plugged sand shark

DRILLERS REMARKS:

description of formations encountered	from	to
White Shale	0	18
White Sand	18	84
Blue Shale	84	280
Gray Sand	280	315
Blue Shale	315	520
Blue Sand	520	572

RECEIVED
AUG 19 1992
Dept. of Environmental Quality
Bureau of Land & Water Resources

If well telescopes please sketch and show depths.

GROUND LEVEL

If more than one screen, show locations of each on sketch.

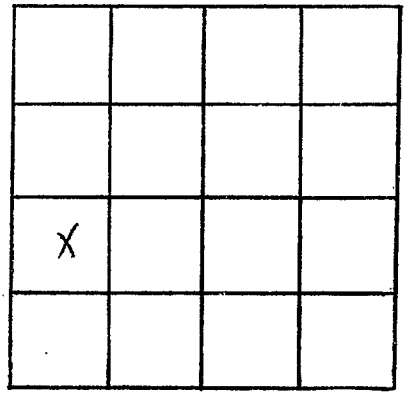

SECTION 18

Please indicate well location X.

ADDITIONAL INFORMATION