PEARL RIVER
V 55
11-16-70

MISSISSIPPI
BOARD OF WATER COMMISSIONERS
416 North State Street
Jackson, Mississippi 39201

CODED

WATER WELL DRILLERS LOG

11-16 date well completed 1970 Ford Hinton & Son firm name Pearl River county well located

LANDOWNER: Charlie Kellar
Rt. 2
Pearl River Miss.
(mailing address)

WELL LOCATION:
sec 34 T 5 N S R 16 E W
½ miles North of Ceasar
(distance) (direction) (nearest town)

WELL PURPOSE: Home
(home, irrigation, municipal, industrial)

WELL COMPLETION DATA:

(1) diameter (inches) 2 in.
(2) total depth (feet) 472
(3) static water level (feet) 82 below above top of ground.
(4) casing Galv., 462,
(material) (depth)
(size) if telescope see back.
(5) screen 10 ft., 462
(length) (depth to top)
2X10, S.S.
(size) (material)
(6) pump 1, 400
(HP) (yield gpm)
elec.
(type power)
(7) electric log no
(yes or no)
(organization running log)
(8) how well bottom plugged Back
Wash Valve

DRILLERS REMARKS:

description of formations encountered	from	to
Red Shale	0	16
Red Sand & Gravel	16	98
Blue Shale	98	436
Blue Sand	436	472

CODED

FEB 4 1971
MISS. BD. OF
WATER COMM.

If well telescopes please sketch and show depths.

GROUND LEVEL

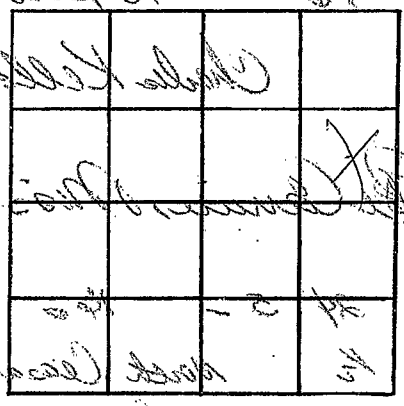

SECTION _____

Please indicate well location X.

ADDITIONAL INFORMATION

If more than one screen, show locations of each on sketch.