

Pearl R.
V-60
4-25-64

MISSISSIPPI BOARD OF WATER COMMISSIONERS

WATER WELL DRILLERS LOG **CODED**

PEARL RIVER

Date: 4/25, 1964, Driller: POUPART
(Name)

County PEARL RIVER

(1) Owner of Land: LAWRENCE
(Name) FRIESON
CHOSAR
(Address)

(2) Location: 1/4, 1/4, Sec. 34 T5R16,
8 miles EAST, of CARRIE
(distance) (direction) (Nearest Town)

(3) Topography: (Hilly) (Flat) (Level)

(4) Purpose of Well: DOMESTIC
(Domestic Irrigation
Municipal, Industrial, Other)

Description & Color of Materials Sand, Clay, Red Clay, Shell, etc.	Thick- ness Feet	Depth Feet
SAND- RED CLAY	60	60
BLUE CLAY	140	200
BLUE SAND	15	215
BLUE CLAY.		
SMALL SAND		
BREAKS	300	515
COURSE SAND	15	530

Information upon completion of well:

(1) Diameter 2 inches.

(2) Total Depth 530 feet.

(3) Water Level 60 feet below top of ground.

(4) Cased to _____, Size _____


(5) Screen: Size 010, Length 10'

(6) Were any formations sealed against pollution?
_____ yes, _____ no.

If YES depth of formation _____

Why _____

Drillers Remarks: _____

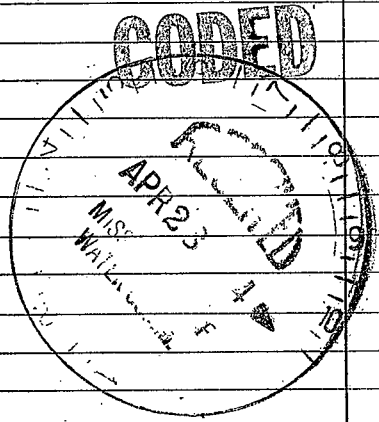

(Use Back Side)

Well No.










