Pearl River
V 2027
7-16-68

MISSISSIPPI
BOARD OF WATER COMMISSIONERS
416 North State Street
Jackson, Mississippi 39201

WATER WELL DRILLERS LOG

7-16 1968 Pontoon Well Serv Pearl River
date well completed — firm name — county well located

LANDOWNER: C L Thompson
Rt. 3 Box 64
Picayune Miss
(mailing address)

WELL LOCATION:
sec. 25 T 5 S R 16 W
1/2 (distance) miles West (direction) of Czesar (nearest town)

WELL PURPOSE: Home
(home, irrigation, municipal, industrial)

WELL COMPLETION DATA: 4½ Drilled

(1) diameter (inches) 2"
(2) total depth (feet) 395'
(3) static water level (feet) 72 below ~~above~~ top of ground.
(4) casing Galv. Steel (material), 390' (depth),
2" (size) If telescope see back.
(5) screen 5' (length), 390 (depth to top)
.012 2" (size), S. Steel (material)
(6) pump 1 (HP) 6 (yield gpm)
Elec (type power)
(7) electric log NO (yes or no)
(organization running log)
(8) how well bottom plugged BW. Valve

DRILLERS REMARKS:

description of formations encountered	From	~~from~~
Clay	0	18
Sand	18	60
White Clay	60	95
Blue Clay	95	160
Mud	160	172
Blue Clay	172	357
Grey Sand	357	395

DUPLICATE
MISS. BOARD OF
WATER COURSE

If well telescopes please sketch and show depths.

GROUND LEVEL

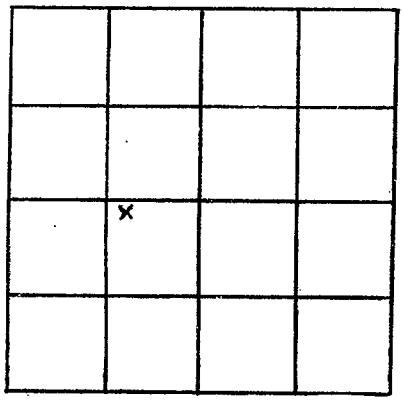

SECTION 25

Please indicate well location X.

ADDITIONAL INFORMATION

If more than one screen, show locations of each on sketch.