MISSISSIPPI DEPARTMENT OF ENVIRONMENTAL QUALITY
Office of Land and Water Resources

P. O. Box 10631
Jackson, MS 39289-0631
WATER WELL DRILLERS LOG

COUNTY WELL LOCATED: Pearl River	
WELL NUMBER: V2830	CODED:
DATE WELL COMPLETED: 10-7-93	
PERMIT NUMBER:	
NAME OF DRILLING FIRM: Bud Penton & Son Water Well Service	

NAME & MAILING ADDRESS OF LANDOWNER
Kay Guidry
1420 Anchor Lake Rd
Carriere Ms 39426

WELL LOCATION: SEC 9 TOWNSHIP 5 N/S RANGE 16 E/W

DISTANCE 3 Miles DIRECTION W of NEAREST TOWN Carriere

OTHER LANDMARK

WELL PURPOSE: Home, Irrigation, Municipal, Industrial, Fish Pond, etc.
Home

PUMP DATA

PUMP TYPE (Circle One): Submersible, Turbine, (Jet) Flowing Well, Other (Describe) _____

POWER TYPE (Circle One): Electric, Tractor, Diesel, Gasoline, Butane, Other (Describe) _____ H/P 1/2

Pump Capacity (GPM)	No. of Stages	Setting Depth
10	1	26 FT.

PUMP TEST

Well yielded _____ GPM with a drawdown of _____ ft. after _____ hours of pumping

WELL DATA

Well Depth	Casing Diameter (In.)	Casing Length (Ft.)
337	2	327

Type of Casing	Hole Depth	Depth to Static Water Level
PVC	337	16

TYPE OF COMPLETION: (Circle One or More): Gravel Packed, Underreamed, Telescoped, Natural Development, Open Hole, Other (Describe) _____

WELL GROUTED TO A DEPTH OF 10 FEET
Type Grout (circle one): Cement, Bentonite, or Mix

LOG DATA

TYPE OF LOG RUN (Circle One): No Log Run, Electric, Gamma Ray, Density, Sonic, Neutron, Other (Describe) _____

Name of Organization Running Log

GEOLOGIC DATA (Office Use Only)

Surface Elev.	Geologic Unit	Unit Thickness	Depth to Top
Subs. SWL	Date	Analysis	Aquifer Test

Driller's Remarks

SCREEN DATA

Diameter - Inches	Length - Feet	Slot Size - Inches
2	10	1010

Screen Type	Depth to Bottom - Feet
PVC	337

DESCRIPTION OF FORMATIONS ENCOUNTERED	FROM	TO
white clay	0	14
white sand	14	35
blue clay	35	308
white sand	308	337

FORMATIONS (Continued)	FROM	TO

RECEIVED
NOV 23 1993
Dept. of Environmental Quality
Office of Land & Water Resources

IF MORE SPACE IS NEEDED, USE BACK

If well telescopes please sketch and show depths.

GROUND LEVEL

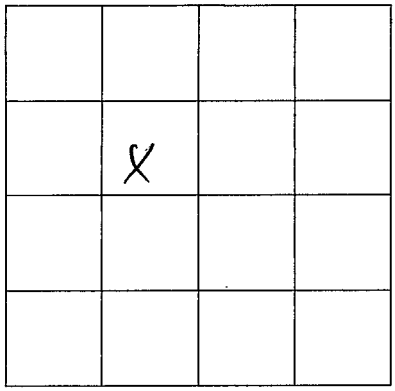

SECTION 9

Please indicate well location X.

ADDITIONAL INFORMATION

If more than one screen, show location of each on sketch.