MISSISSIPPI DEPARTMENT OF ENVIRONMENTAL QUALITY
Office of Land and Water Resources

P. O. Box 10631
Jackson, MS 39289-0631
WATER WELL DRILLERS LOG

COUNTY WELL LOCATED	Pearl River
WELL NUMBER	V2122
CODED	
DATE WELL COMPLETED	7-16-93
PERMIT NUMBER	
NAME OF DRILLING FIRM	Bud Penton & Son Water Well Service

NAME & MAILING ADDRESS OF LANDOWNER
Chris Burge
193 Rayburn Rd
Carriere Ms 39426

WELL LOCATION: SEC 28 TOWNSHIP 5 N (S) RANGE 16 E (W)

DISTANCE 3 Miles DIRECTION E of NEAREST TOWN Carriere

OTHER LANDMARK

WELL PURPOSE: Home, Irrigation, Municipal, Industrial, Fish Pond, etc.
Home

PUMP DATA

PUMP TYPE (Circle One): Submersible, Turbine, (Jet) Flowing Well, Other (Describe)

POWER TYPE (Circle One): (Electric) Tractor, Diesel, Gasoline, Butane, Other (Describe) H/P 1

Pump Capacity (GPM)	No. of Stages	Setting Depth
15	2	50 FT.

PUMP TEST

Well yielded _____ GPM with

a drawdown of _____ ft.

after _____ hours of pumping

WELL DATA

Well Depth	Casing Diameter (In.)	Casing Length (Ft.)
574	2	564

Type of Casing	Hole Depth	Depth to Static Water Level
PVC	574	40

TYPE OF COMPLETION: (Circle One or More): Gravel Packed, Underreamed, Telescoped, (Natural Development), Open Hole, Other (Describe)

WELL GROUTED TO A DEPTH OF 10 FEET
Type Grout (circle one): (Cement), Bentonite, or Mix

LOG DATA

TYPE OF LOG RUN (Circle One): (No Log Run) Electric, Gamma Ray, Density, Sonic, Neutron, Other (Describe)

Name of Organization Running Log

GEOLOGIC DATA (Office Use Only)

Surface Elev.	Geologic Unit	Unit Thickness	Depth to Top
Subs. SWL	Date	Analysis	Aquifer Test

Driller's Remarks

SCREEN DATA

Diameter - Inches	Length - Feet	Slot Size - Inches
2	10	.010

Screen Type	Depth to Bottom - Feet
PVC	574

DESCRIPTION OF FORMATIONS ENCOUNTERED	FROM	TO	FORMATIONS (Continued)	FROM	TO
blue clay	0	200			
blue sand	200	220			
blue clay	220	390			
gray sand	390	441			
blue clay	441	470			
gray sand	470	574			
			IF MORE SPACE IS NEEDED, USE BACK		

RECEIVED
NOV 23 1993
Dept. of Environmental Quality
Office of Land & Water Resources

If well telescopes please
sketch and show depths.

GROUND LEVEL

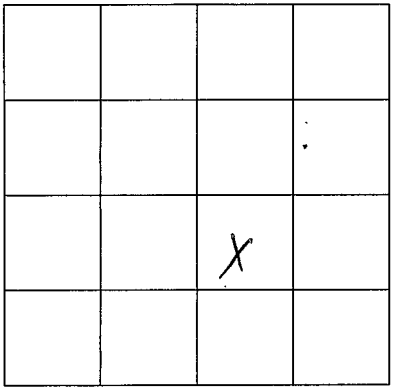

SECTION 28

Please indicate well location X.

ADDITIONAL INFORMATION

If more than one screen,
show location of each on sketch.