Pearl River
W 13
11-5-68

CODED

CODED

CODED

MISSISSIPPI
BOARD OF WATER COMMISSIONERS
416 North State Street
Jackson, Mississippi 39201

WATER WELL DRILLERS LOG

11-5- 1968 NEIL HUMPKIN WELL Pearl River
date well completed — DRILLING firm name SERVICE — county well located

LANDOWNER: Dr. O.N. Leist
Picayune, Miss.
(mailing address)

WELL LOCATION:
sec 30 T 7 ~~N~~ S R 17 ~~E~~ W
7 (distance) miles SW (direction) of Picayune (nearest town)

WELL PURPOSE: Cattle
(home, irrigation, municipal, industrial)

WELL COMPLETION DATA:

(1) diameter (inches) 2"
(2) total depth (feet) 746'
(3) static water level (feet) 40 ~~below~~ above top of ground.
(4) casing blk. (material), 693 (depth), 2" (size) if telescope see back.
(5) screen 10' (length), (depth to top), 2" (size), st. steel (material)
(6) pump (HP) (yield gpm) (type power)
(7) electric log no (yes or no)
no (organization running log)
(8) how well bottom plugged back pressure valve

DRILLERS REMARKS: 42" galv. on top of blk. casing.

description of formations encountered	from	to
Surface Clay	0	15
" sand & grav.	15	100
Blue Clay	100	180
Good sand (pump well)	180	235
Blue Clay	235	400
Grey sand	400	550
Blue Clay	550	695
Good sand	695	746

CODED

JAN 13 1969

MISS. BD. OF WATER COMMISSIONERS

If well telescopes please sketch and show depths.

GROUND LEVEL

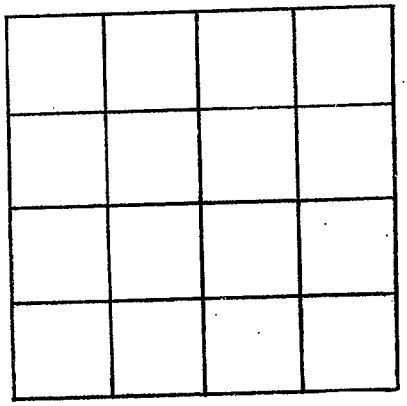

SECTION _____

Please indicate well location X.

ADDITIONAL INFORMATION

If more than one screen, show locations of each on sketch.