

W-37

6-8-64

WATER WELL DRILLERS LOG

CODED River

Date: 6-8, 1964, Driller: Walter Penford County: Winn
9032-9233 (Name)

(1) Owner of Land: Elwood Andrews
 (Name)
Picayune MISS
 (Address)
 (2) Location: 32 $\frac{1}{4}$, 27 $\frac{1}{4}$, Sec. T6 R17,
1 miles S.W. of Picayune
 (distance) (direction) (Nearest Town)
 (3) Topography: Flat
 (Hilly) (Flat) (Level)
 (4) Purpose of Well:
 (Domestic Irrigation
 Municipal, Industrial, Other)


Description & Color of Materials Sand, Clay, Red Clay, Shell, etc.	Thick- ness Feet	Depth Feet
<u>yellow clay</u>	<u>18</u>	<u>to 18</u>
<u>Sand + Gravel</u>	<u>69</u>	<u>87</u>
<u>Blue clay</u>	<u>263</u>	<u>368</u>
<u>Grey Sand</u>	<u>169</u>	<u>537</u>
<u>Blue Clay</u>	<u>85</u>	<u>622</u>
<u>Grey Sand</u>	<u>11</u>	<u>633</u>
<u>Blue Clay</u>	<u>31</u>	<u>664</u>
<u>Grey Sand</u>	<u>15</u>	<u>679</u>
<u>Blue Clay</u>	<u>143</u>	<u>822</u>
<u>Grey Sand</u>	<u>77</u>	<u>899</u>
<u>Grey Sand</u>	<u>64</u>	<u>886</u>
<u>Blue Clay</u>	<u>6</u>	<u>892</u>
<u>Grey Sand</u>		<u>926</u>

Information upon completion of well:

(1) Diameter 2 inches.
 (2) Total Depth 926 feet.
 (3) Water Level Flow feet below top of ground.
 (4) Cased to _____, Size _____
 (5) Screen: Size .D10, Length 20
 (6) Were any formations sealed against pollution?
 _____ yes, _____ no.

If YES depth of formation _____
 Why _____
 Drillers Remarks: 17 lbs. Pressure

CODED

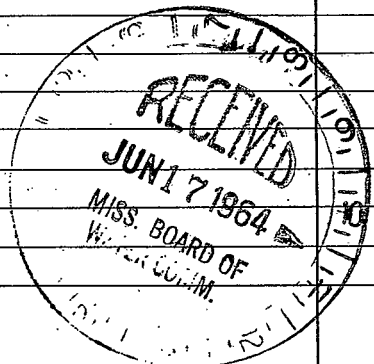

(Use Back Side)

Well No.







