P.R.
W64
12-30-74

MISSISSIPPI
BOARD OF WATER COMMISSIONERS
416 North State Street
Jackson, Mississippi 39201

WATER WELL DRILLERS LOG

CODED

12-30 1974 Lumpkin Well Co. Pearl River
date well completed firm name county well located

LANDOWNER: Millbrook Country Club
Pinaguma, Miss
(mailing address)

WELL LOCATION:
sec. 1 T 6 N (S) R 17 E (W)
2 miles North of Pinaguma
(distance) (direction) (nearest town)

WELL PURPOSE: Irrigation
(home, irrigation, municipal, industrial)

WELL COMPLETION DATA:
(1) diameter (inches) 6" x 4"
(2) total depth (feet) 385'
(3) static water level (feet) 42' below above top of ground.
(4) casing P.V.C. (material), 365' (depth), 6"x4" (size) if telescope see back.
(5) screen 30' (length), 365' (depth to top), 4" (size), P.V.C (material)
(6) pump 7½ (HP) 210 G.P.M. (yield gpm)
Elec. (type power)
(7) electric log No. (yes or no)
(organization running log)
(8) how well bottom plugged Sand Shoe

DRILLERS REMARKS:

description of formations encountered	from	to
Clay	0	15
Sand	15	110
Clay	110	150
Sand	150	190
Clay	190	240
Sand	240	260
Clay	260	335
Sand	335	385

CODED

RECEIVED
JAN 22 1975
MISS. BD. OF WATER

(8) If well telescopes please sketch and show depths.

GROUND LEVEL

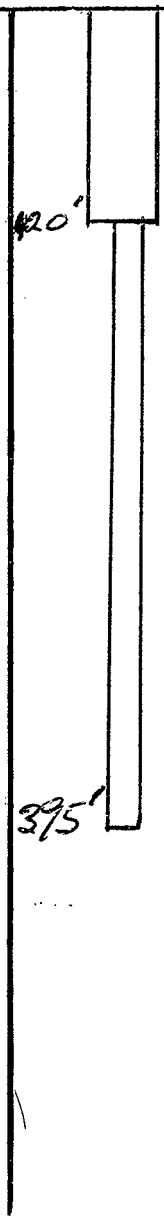

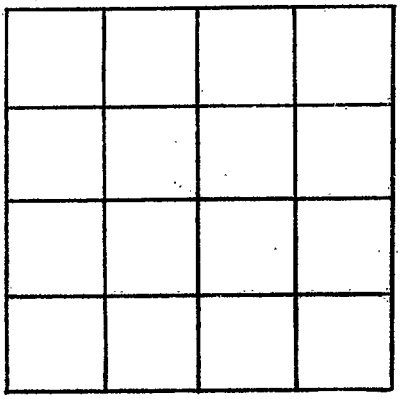

SECTION _____

Please indicate well location X.

ADDITIONAL INFORMATION

If more than one screen, show locations of each on sketch.