Pearl River
W 2014
3/10/78

MISSISSIPPI
BOARD OF WATER COMMISSIONERS
416 North State Street
Jackson, Mississippi 39201

WATER WELL DRILLERS LOG

3-10-78 19 Penton Well Serv Pearl River
date well completed firm name county well located

LANDOWNER: Sidney Mitchell
Rt 4
Picayune MS
(mailing address)

WELL LOCATION:
sec 28 T 6 S R 17 W
1/2 miles S.W. of Picayune
(distance) (direction) (nearest town)

WELL PURPOSE: Home
(home, irrigation, municipal, industrial)

WELL COMPLETION DATA:

(1) diameter (inches) 2"
(2) total depth (feet) 369'
(3) static water level (feet) 18 below ~~above~~ top of ground.
(4) casing Galv (material), 359' (depth), 2" (size) if telescope see back.
(5) screen 10 (length), 359 (depth to top), 2" (size), S. Steel (material)
(6) pump 1/2 (HP) 10 (yield gpm) Elec (type power)
(7) electric log No (yes or no)
(organization running log)
(8) how well bottom plugged B W Valve

DRILLERS REMARKS:

description of formations encountered	from	to
Clay	0	30
Sand + Gravel	30	100
Blue Clay	100	230
Sand + Clay	230	300
Sand	300	369

RECEIVED
APR 13 1978
MISS. BD. OF WATER COMM.

If well telescopes please sketch and show depths.

GROUND LEVEL

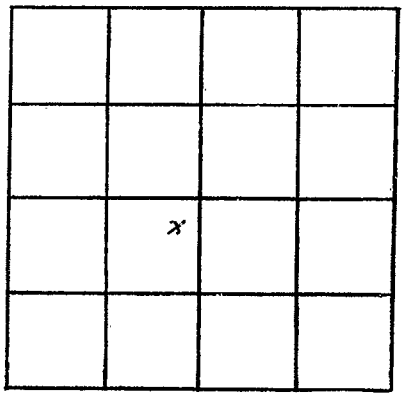

SECTION 28

Please indicate well location X.

ADDITIONAL INFORMATION

If more than one screen, show locations of each on sketch.