Pearl River
W W
2086

MISSISSIPPI DEPARTMENT OF NATURAL RESOURCES

Bureau of Land and Water Resources
Southport Mall
P.O. Box 10631
Jackson, Mississippi 39209

WATER WELL DRILLERS LOG

12-20 1984 PENTON WELL SERV. PEARL RIVER
date well completed — firm name — county well located

LANDOWNER: C.C. Ferris
Sec. Line Rd
Picayune MS.
(mailing address)

WELL LOCATION:
sec. 27 T 6 N/S R 17 E/W
1/2 (distance) miles S (direction) of Picayune (nearest town)

WELL PURPOSE: HOME
(home, irrigation, municipal, industrial)

WELL COMPLETION DATA:

(1) diameter (inches) 2
(2) total depth (feet) 480'
(3) static water level (feet) 15' below ~~above~~ top of ground.
(4) casing PVC (material), 470' (depth), 2 (size) if telescope see back.
(5) screen 10' (length), 470' (depth to top), 2 (size), PVC (material)
(6) pump _____ (HP) _____ (yield gpm)
_____ (type power)
(7) electric log NO (yes or no)
_____ (organization running log)
(8) how well bottom plugged BW

DRILLERS REMARKS:

description of formations encountered	from	to
SURFACE CLAY	0	20
SAND	20	75
BLUE CLAY	75	190
SAND	190	260
BLUE CLAY	260	400
SAND	400	480

RECEIVED
JAN 24 1985
Department of Natural Resources
Bureau of Land & Water Resources

If well telescopes please sketch and show depths.

GROUND LEVEL

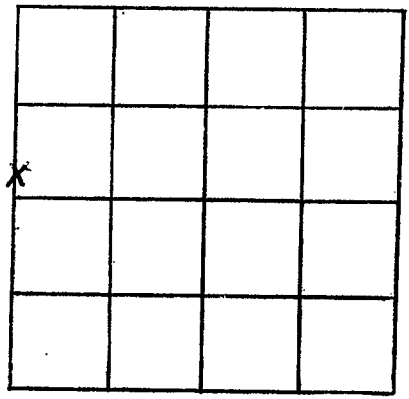

SECTION 27

Please indicate well location X.

ADDITIONAL INFORMATION

If more than one screen, show locations of each on sketch.