MISSISSIPPI DEPARTMENT OF NATURAL RESOURCES

Bureau of Land and Water Resources

P.O. Box 10631
Jackson, Mississippi 39209
WATER WELL DRILLERS LOG

COUNTY WELL LOCATED: Pearl River	PERMIT NUMBER: 0-477
WELL NUMBER: W 2110 — CODED:	NAME OF DRILLING FIRM: Penton Well Serv.
DATE WELL COMPLETED: 7-17-87	Nicholson, MS.

NAME & MAILING ADDRESS OF LANDOWNER
Wendell Moody
P.O. Box 818
Picayune, MS. 39466

WELL LOCATION: SEC 15 TOWNSHIP 6 ☒ S RANGE 17 ☒ W

DISTANCE 0 Miles DIRECTION 0 of NEAREST TOWN Picayune

OTHER LANDMARK

WELL PURPOSE: Home, Irrigation, Municipal, Industrial, Fish Pond, etc.
Monitor

PUMP DATA

PUMP TYPE (Circle One): Submersible, Turbine, Jet, Flowing Well, Other (Describe) _____

POWER TYPE (Circle One): Electric, Tractor, Diesel, Gasoline, Butane, Other (Describe) _____

Pump Capacity (GPM)	No. of Stages	Setting Depth
		FT.

PUMP TEST

Well yielded _____ GPM with a drawdown of _____ ft. after _____ hours of pumping

WELL DATA

Well Depth	Casing Diameter (In.)	Casing Length (Ft.)
62'	2"	52'
Type of Casing	**Hole Depth**	**Depth to Static Water Level**
PVC	62'	18'

TYPE OF COMPLETION: (Circle One or More): (Gravel Packed,) Underreamed, Telescoped, Natural Development, Open Hole, Other (Describe) _____

Top of Lap Pipe or Reduction in Casing
FEET — IF TELESCOPED OR MORE THAN ONE SCREEN: USE BACK PAGE

LOG DATA

TYPE OF LOG RUN (Circle One): (No Log Run,) Electric, Gamma Ray, Density, Sonic, Neutron, Other (Describe) _____

Name of Organization Running Log

GEOLOGIC DATA (Office Use Only)

Surface Elev.	Geologic Unit	Unit Thickness	Depth to Top
Subs. SWL	Date	Analysis	Aquifer Test

Driller's Remarks

SCREEN DATA

Diameter - Inches	Length - Feet	Slot Size - Inches
2"	10'	10
Screen Type	**Depth to Bottom - Feet**	
PVC	62'	

RECEIVED
JUL 29 1987
Department of Natural Resources
Bureau of Land & Water Resources

DESCRIPTION OF FORMATIONS ENCOUNTERED	FROM	TO
Clay	0	18
Sand	18	30
Clay	30	40
Sand	40	62

FORMATIONS (Continued)	FROM	TO

IF MORE SPACE IS NEEDED, USE BACK

If well telescopes please
sketch and show depths.

GROUND LEVEL

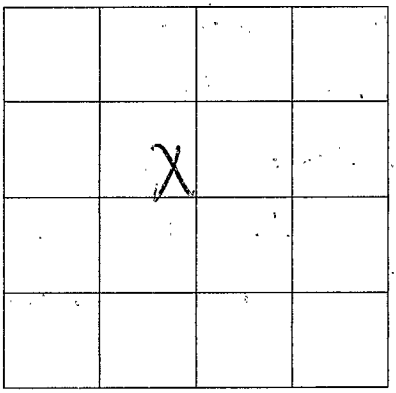

SECTION _____

Please indicate well location X.

ADDITIONAL INFORMATION

If more than one screen,
show location of each on sketch.